

KANAS Butler

Section 8 Township 26 Range 3E

Well No. 1 Brannan (Breneman)

Company K.T. Weidemann

Misc.
NORTH

WEST

0

EAST

SOUTH

KANSAS

Butler

Sec. 8 Twp. 26 R. 3E

Well No. #1 Brannan Farm

K. T. Weidemann

Company

Miscellaneous (Weidemann, Cont.)


330' Ft. from N. Line

Ft. from S. Line

Ft. from E. Line

330' Ft. from W. Line

NW/C

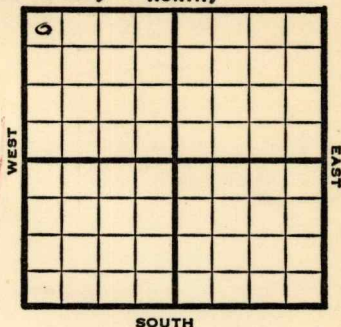

1949

Elev. 1329'

REPORT

5/11	Location
5/18	8" @ 82'
5/25	"
6/1	Dr1g. 2500'
6/7	Miss 2799' TD 2800 5" @ 2800'
6/15	"
6/21	"
6/28	TD 2803' 1300' fluid 98% W
7/6	TD 2816' 10 qts 2802-09' CO
7/12	Sqz/
7/20	"
7/27	"
8/3	"
8/10	"
8/16	"
8/24	"
8/31	"
9/7	"
9/14	"
9/21	"
9/28	"
10/5	"

OVER

1949

10/12 Sqz.

10/19 "

10/26 "

11/1 "

11/9 "

11/16 "

11/23 "

11/29 "

12/7 TD 2825'

12/14 Miss 2799'

TD 2864'

ABANDONED

Name

Map No. _____ Sec. 8 Twp. 26 R. 3EWell No. 1 BrannanK. T. Weidemann

Company

Weidemann

Contractor

NW/C

FIRST REPORT
SECTION PLAT330


Ft. from N. Line

Ft. from S. Line

Ft. from E. Line

330

Ft. from W. Line

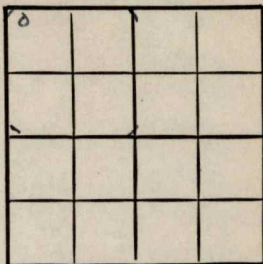Butler CountyLocation X

Rig up _____

Drilling and Remarks:

RECORD

Cased _____ in., _____ ft.

Sand _____

Gas _____

Oil _____

Total Depth _____

PRODUCTION

1st 24 hrs. Nat. _____

1st 24 hrs. after shot _____

Gas _____ Cu. Ft.

Dry Hole _____

Abandoned _____

Date

MAY 11 1949 19S. J. LEWIS

Scout

Map No. _____ Sec. 8 Twp. 226 R. 3E

Well No. 1 Brannan

K. T. Weidemann Company

ABANDONED

Contractor

NW/C

E1, 1325
SECTION PLAT

330 Ft. from N. Line

_____ Ft. from S. Line

_____ Ft. from E. Line

330 Ft. from W. Line

<i>6</i>			

Butler County

Location _____

Rig up _____

Drilling and Remarks:

Miss 2799

RECORD

Cased _____ in., _____ ft.

Sand _____

Gas _____

Oil _____

Total Depth 2864

PRODUCTION

1st 24 hrs. Nat. _____

1st 24 hrs. after shot _____

Gas _____ Cu. Ft.

Dry Hole _____

Abandoned _____

Date

DEC 14 1949

19

S. J. LEWIS

Scout