


Section 10 Township 26 Range 3E

Well No. #1 Glancy

Company Cox & Burns

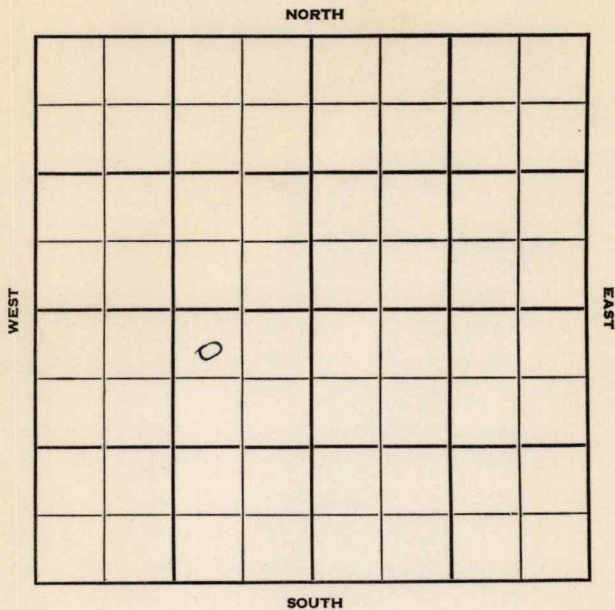

Butler

KANSAS

Sec. 10 Twp. 26 R. 3E

Well No. #1 Glancy Farm

Cox & Burns Company

Morrison Drlg. - Contr. Contractor

Benton Pool


330' Ft. from N. Line

Ft. from S. Line

990' Ft. from E. Line

Ft. from W. Line

NW NE SW

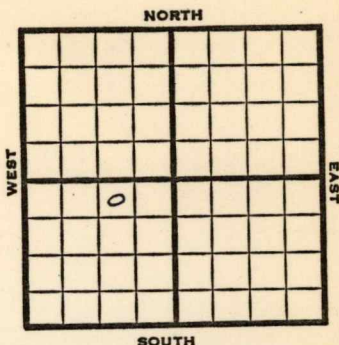

1951

Elev. 1351' REPORT

4/4 Spud 3-31-51
8" @ 103'
Drlg. 1450'

4/11 Spud 3-31-51
D&A TD 2834
8" @ 103
Chat 2772 Miss 2785-2834 TD
D&A

ABANDONED

County **Butler** State **Kansas**
Sec. **10** (Blk. **26** (Sur. **3E** Map No.
Operator **Cox & Burns**
Well No. **1** Farm **Glancy**
Elev. Location **NW NE SW**



330 Ft. From **N** Line **SW**
990 Ft. From **E** Line **Quarter**
1st. Report **APR 4 1951**

Completion


Remarks

Morrison Drlg. - Contr.

Spudding Date **3-31-51**

Drlg. Data **Benton Pool**

8" @ 103 drlg. 1450

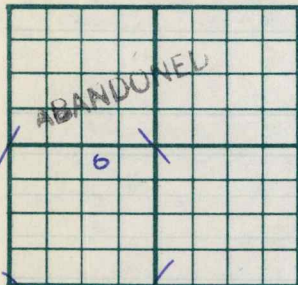County Butler State KansasSec. 10 (Blk.) 26 (Sur.) 3E Map No.Operator Cox & BurnsWell No. 1 Farm GlancyElev. 1351 Location NW NE SW330 Ft. From N Line SW990 Ft. From E Line Quarter1st. ReportCompletion APR 11 1951Remarks Benton PoolMorrison Drlg. - Contr.Spudding Date 3-31-51Drlg. Data D & A TD 28348" @ 103 Chat. 2772 Miss. 2785-2834 TDD & A

J. E. TYRA