


Section 10 Township 26 Range 3-E

Well Number 1 Clancey

Company Aylward & Wixson

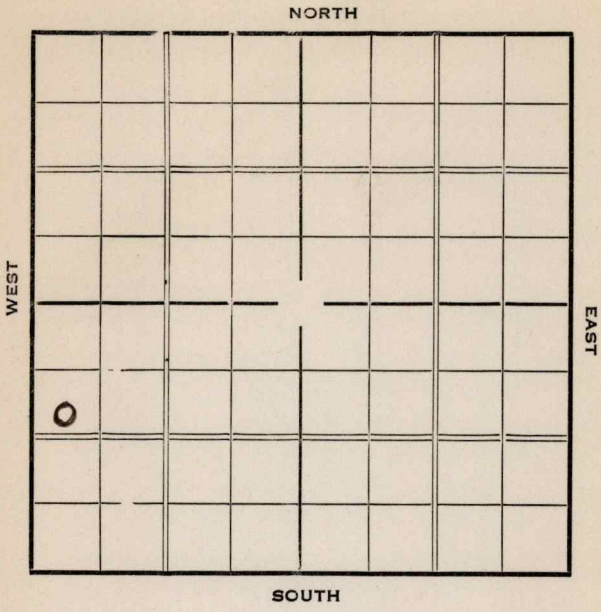

KANSAS*Butler*Map No. 13 Sec. 10 Twp. 26 R. 34Well No. 1 ClanceyAylward & Hixson Company

Contractor

SECTION PLAT

0			

1120 Ft. from N. Line

_____ Ft. from S. Line

_____ Ft. from E. Line

330 Ft. from W. Line**FIRST REPORT**

Location _____

Rig up _____

Drilling and Remarks:

*Mach***RECORD**

Cased _____ in., _____ ft.

Sand _____

Gas _____

Oil _____

Total Depth _____

PRODUCTION

1st 24 hrs. Nat. _____

1st 24 hrs. after shot _____

Gas _____ Cu. Ft.

Dry Hole _____

Abandoned _____

Date

MAR 31 1937 19

S. J. LEWIS Scout

Butler

KANSAS

Map No. 13 Sec. 10 Twp. 26 R. 3EWell No. 1-ClanceyAylward & Wixson Company

Contractor

ABANDONED

SECTION PLAT

0			

1120 Ft. from N. Line

_____ Ft. from S. Line

_____ Ft. from E. Line

330 Ft. from W. Line

Location _____

Rig up _____

Drilling and Remarks:

D & A

RECORD

Cased _____ in., _____ ft.

Sand MISS - 2765

Gas _____

Oil _____

Total Depth 2845

PRODUCTION

1st 24 hrs. Nat. _____

1st 24 hrs. after shot _____

Gas _____ Cu. Ft.

Dry Hole _____

Abandoned _____

Date

MAY 12 1937

19

H. D. Hatfield

Scout