

Map No. _____ Sec 21 Twp 27 R 4Well No. 13 Peuley Farm _____Empire Company _____

NORTH

WEST

EAST

SOUTH

Location _____

Rig Up 12/11/16

Drilling Remarks:

Drilling Remarks:

Q 91: 12/18: 12/28
400 = 1/8/17
678: 1/15

RECORD

Cased _____ in _____ Ft.
 Sand _____
 Gas _____
 Oil _____
 Total Depth _____

PRODUCTION


1st 24 hrs. Nat. _____
 1st 24 hrs. after shot _____
 Gas _____ Cu. Ft.
 Dry Hole _____
 Abandoned _____

Map No. _____ Sec. 21 Twp. 27 R. 4
 Well No. 13 Pandey Farm _____
Empire Company _____

NORTH

WEST

EAST

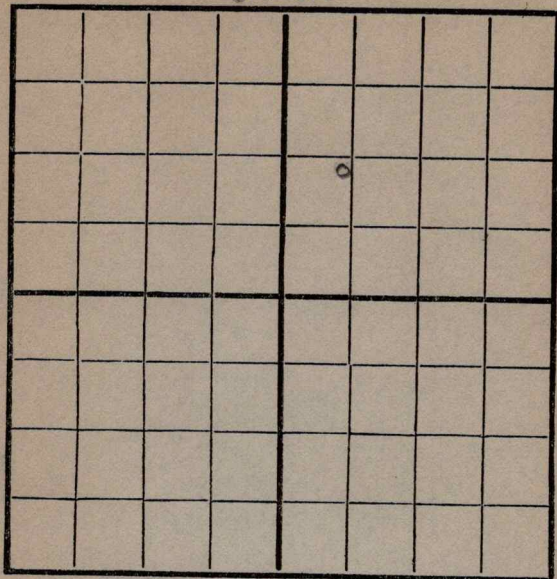

SOUTH

Location _____
 Rig Up ☒ _____
 Drilling and remarks _____

RECORD

Cased _____ in. _____ Ft.
 Sand _____
 Gas _____
 Oil _____
 Total Depth _____

PRODUCTION

1st 24 hrs. Nat. _____
 1st 24 hrs. after shot _____
 Gas _____ Cu. Ft.
 Dry Hole _____
 Abandoned _____


Date

12/11, 1916, Pandey Scout

Map No. _____ Sec. 21 Twp. 27 R. 4Well No. 13 Penley Farm __________
Company _____

NORTH

WEST

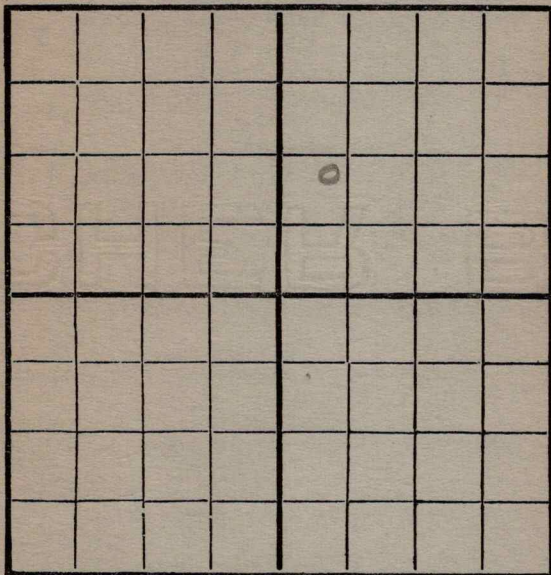

EAST

SOUTH

Location _____

Rig Up _____

Drilling and remarks

Rigged up

RECORD

Cased _____ in. _____ Ft.

Sand _____

Gas _____

Oil _____

Total Depth _____

PRODUCTION

1st 24 hrs. Nat. _____

1st 24 hrs. after shot _____

Gas _____ Cu. Ft.

Dry Hole _____

Abandoned _____

Date


10/18, 1916 *Conley* Scout

Map No. _____ Sec. 31 Twp. 27 R. 4Well No. 13 Perle Farm _____Company Empire

NORTH

WEST

EAST

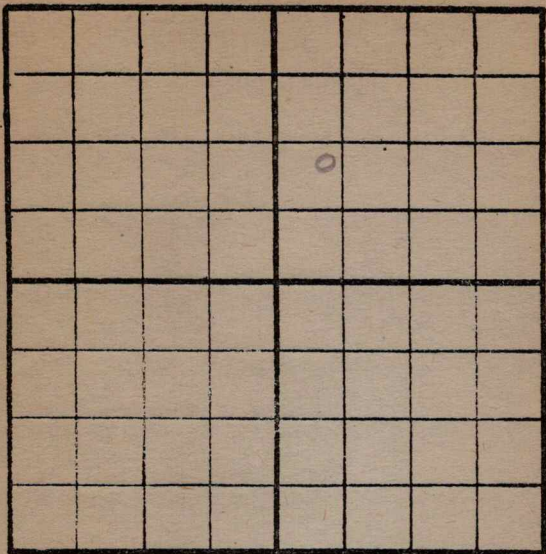

SOUTH

Location _____

Rig up _____

Drilling and remarks:

Rigged up

RECORD

Cased _____ in. _____ Ft.

Sand _____

Gas _____

Oil _____

Total Depth _____

PRODUCTION

1st. 24 hrs. Nat. _____

1st. 24 hrs. after shot _____

Gas _____ Cu. Ft.

Dry Hole _____

Abandoned _____

Date

12/28, 1916, Perle Scout

Map No. _____ Sec. 21 Twp. 22 R. 4Well No. 13 Perry Farm _____

_____ Company _____

NORTH

WEST

EAST

SOUTH

Location _____

Rig Up _____

Drilling and remarks

Rigged up

RECORD

Cased _____ in. _____ Ft.

Sand _____

Gas _____

Oil _____

Total Depth _____

PRODUCTION

1st 24 hrs. Nat. _____

1st 24 hrs. after shot _____

Gas _____ Cu. Ft.

Dry Hole _____

Abandoned _____


Date

1/1, 1917 *Conley* Scout

Map No. _____ Sec. 21 Twp. 27 R. 4
 Well No. 13 Perry Farm _____
Enterprise Company _____

NORTH

WEST

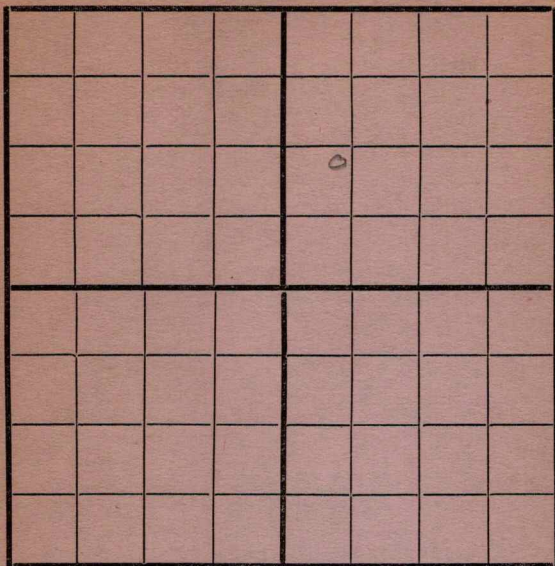

EAST

SOUTH

Location _____
 Rig Up _____
 Drilling and remarks

400'

RECORD

Cased _____ in. _____ Ft.
 Sand _____
 Gas _____
 Oil _____
 Total Depth _____

PRODUCTION

1st 24 hrs. Nat. _____
 1st 24 hrs. after shot _____
 Gas _____ Cu. Ft.
 Dry Hole _____
 Abandoned _____

Date


1/8, 1917 C. D. Jeff Scout

Map No. _____ Sec. 31 Twp. 37 R. 4
 Well No. 13 _____ Farm _____
 _____ Company _____

NORTH

WEST

EAST

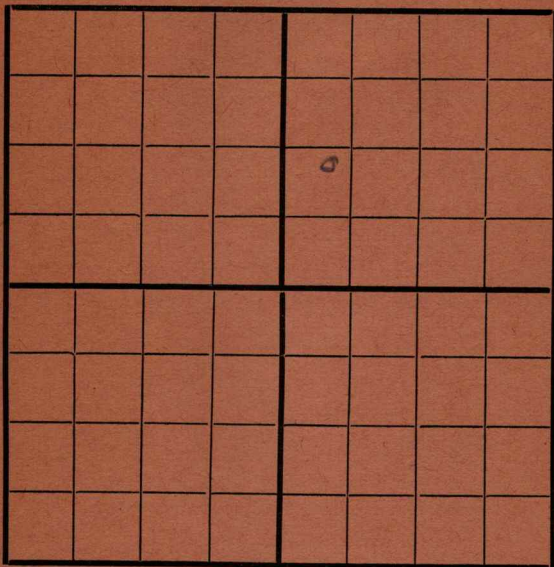

SOUTH

Location _____
 Rig Up _____
 Drilling and remarks _____

678'

RECORD

Cased _____ in. _____ Ft.
 Sand _____
 Gas _____
 Oil _____
 Total Depth _____

PRODUCTION

1st 24 hrs. Nat. _____
 1st 24 hrs. after shot _____
 Gas _____ Cu. Ft.
 Dry Hole _____
 Abandoned _____

Date _____


1/15, 1912 _____ Scout _____

Map No. _____ Sec. 31 Twp. 27 R. 4
 Well No. 13 _____ Farm _____
 _____ Company _____

NORTH

WEST

EAST

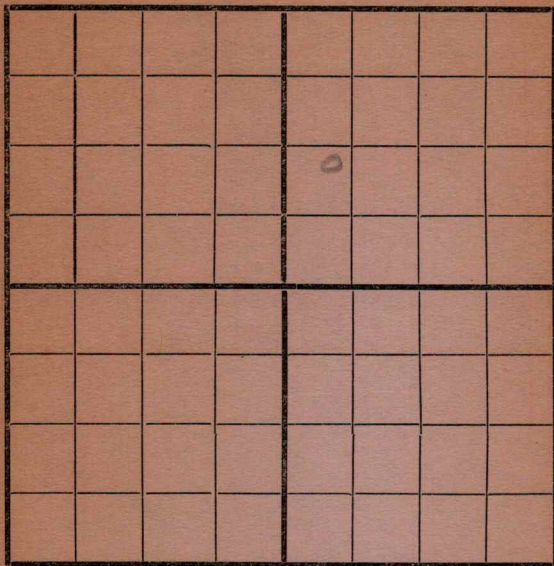

SOUTH

Location _____

Rig Up _____

Drilling and remarks

1020

RECORD

Cased _____ in. _____ Ft.

Sand _____

Gas _____

Oil _____

Total Depth _____

PRODUCTION

1st 24 hrs. Nat. _____

1st 24 hrs. after shot _____

Gas _____ Cu. Ft.

Dry Hole _____

Abandoned _____

Date

1/22, 1917 Co. J. J. Scout

Map No. _____ Sec. 21 Twp. 27 R. 4Well No. 13 Perry _____ Farm

_____ Company

NORTH

WEST

EAST

SOUTH

Location _____

Rig Up _____

Drilling and remarks

1220'

RECORD

Cased _____ in. _____ Ft.

Sand _____

Gas _____

Oil _____

Total Depth _____

PRODUCTION

1st 24 hrs. Nat. _____

1st 24 hrs. after shot _____

Gas _____ Cu. Ft.

Dry Hole _____


Abandoned _____

Date

1/29, 1917 C. Perry Scout

Map No. _____ Sec. 21 Twp. 27 R. 4
 Well No. 13 Perry Farm _____
Empire Company _____

NORTH

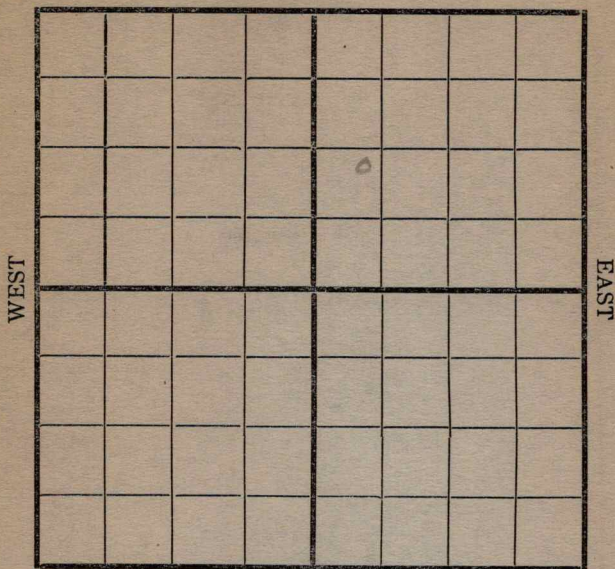

SOUTH

Location _____
 Rig Up _____
 Drilling and remarks _____

1308

RECORD

Cased _____ in. _____ Ft.
 Sand _____
 Gas _____
 Oil _____
 Total Depth _____

PRODUCTION


1st 24 hrs. Nat. _____
 1st 24 hrs. after shot _____
 Gas _____ Cu. Ft.
 Dry Hole _____
 Abandoned _____

Date

2/5, 1917 Carroll Scout

Map No. _____ Sec. 21 Twp. 27 R. 4
Well No. 13 Penley Farm _____
Caroline Company _____

NORTH

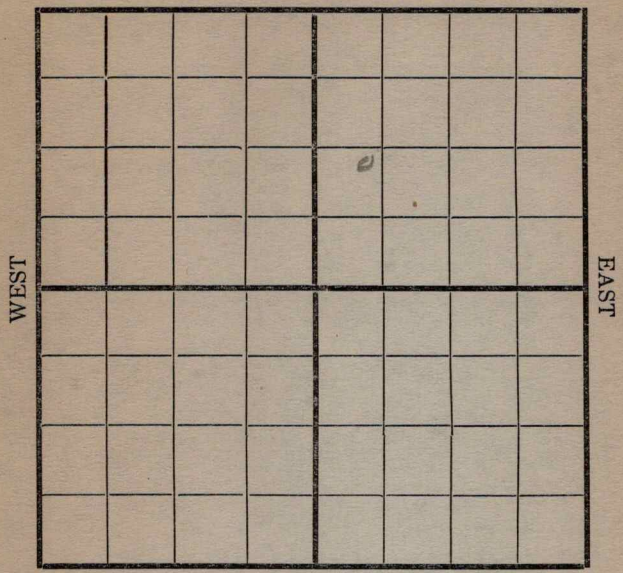

SOUTH


Location _____ Rig Up _____ Drilling and remarks <u>1925</u>	RECORD
	Cased _____ in. _____ Ft.
	Sand _____
	Gas _____
	Oil _____
	Total Depth _____
	PRODUCTION
	1st 24 hrs. Nat. _____
	1st 24 hrs. after shot _____
	Gas _____ Cu. Ft.
	Dry Hole _____
	Abandoned _____

Date Feb 7 1917 Caroline Scout

Map No. _____ Sec. 21 Twp. 27 R. 4
 Well No. 13 Perry Farm _____
Enterprise Company _____

NORTH

WEST

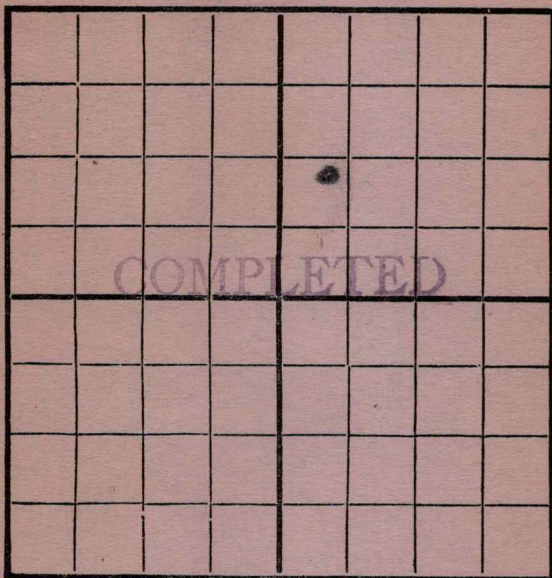

EAST

SOUTH

Location _____
 Rig Up _____
 Drilling and remarks _____

Est at
40366

RECORD

Cased _____ in. _____ Ft.
 Sand 1907-1994
 Gas _____
 Oil _____
 Total Depth _____

PRODUCTION

1st 24 hrs. Nat. _____
 First 24 hrs. after shot _____
 Gas _____ Cu. Ft.
 Dry Hole _____
 Abandoned _____


Date

2/19 191 7 Enterprise Scout

Map No. _____ Sec. 21 Twp. 27 R. 4
 Well No. 13 Peckley Farm _____
Empire Company _____

NORTH

WEST

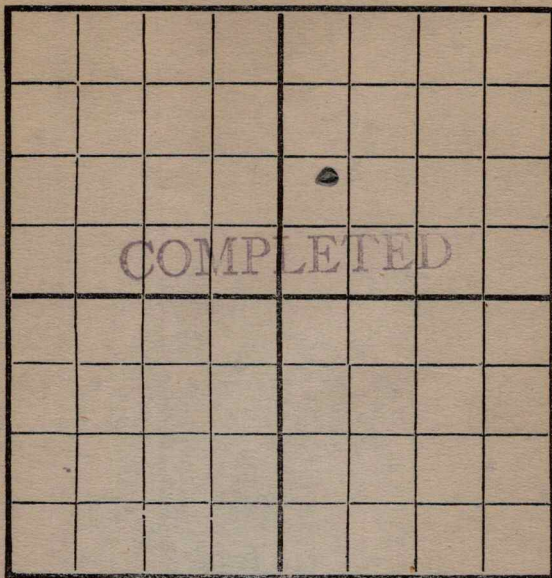

EAST

SOUTH

Location _____
 Rig Up _____
 Drilling and remarks _____

Est at
40 Bbls

RECORD

Cased _____ in. _____ Ft.
 Sand 1907-1994
 Gas _____
 Oil _____
 Total Depth _____

PRODUCTION

1st 24 hrs. Nat. _____
 First 24 hrs. after shot _____
 Gas _____ Cu. Ft.
 Dry Hole _____
 Abandoned _____

Date

2/19 1917 Candis Scout _____