

Map No. _____ Sec. 21 Twp. 27 R. 4Well No. 15-Penley Farm _____Company Empire _____

NORTH

WEST

EAST

COMPLETED

SOUTH

Location _____

Rig Up 12-28-16

Drilling Remarks:

Drilling Remarks:

Spudding 1/8/17
420' 1/10"

RECORD

PRODUCTION

Cased _____ in _____ Ft.

1st 24 hrs. Nat. _____

Sand _____

1st 24 hrs. after shot _____

Gas _____

Gas _____ Cu. Ft.

Oil _____

Dry Hole _____


Total Depth _____

Abandoned _____

Map No. Augusta Sec. 21 Twp. 27 R. 4
 Well No. 15 Penney Farm
Penney Company

Kub NORTH as

WEST

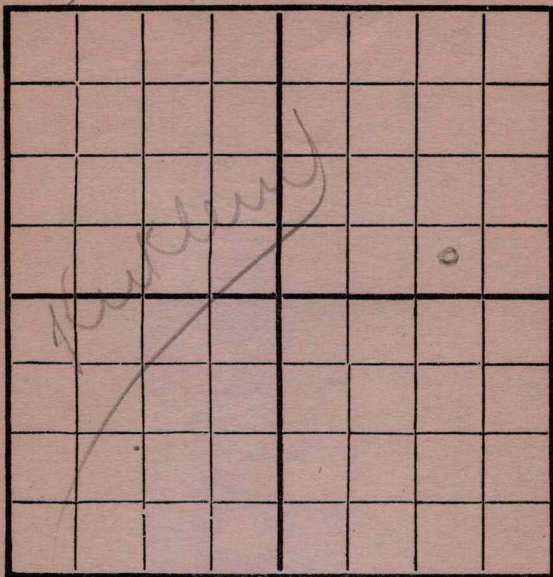

EAST

SOUTH

Location _____

Rig Up ☒ _____

Drilling and remarks _____

RECORD

Cased _____ in. _____ Ft.

Sand _____

Gas _____

Oil _____

Total Depth _____

PRODUCTION

1st 24 hrs. Nat. _____

First 24 hrs. after shot _____

Gas _____ Cu. Ft.

Dry Hole _____

Abandoned _____


Date

12/28, 1916 Carroll Scout

Map No. _____ Sec. 21 Twp. 27 R. 4
 Well No. 15 Barclay _____ Farm
campsite _____ Company

NORTH

WEST

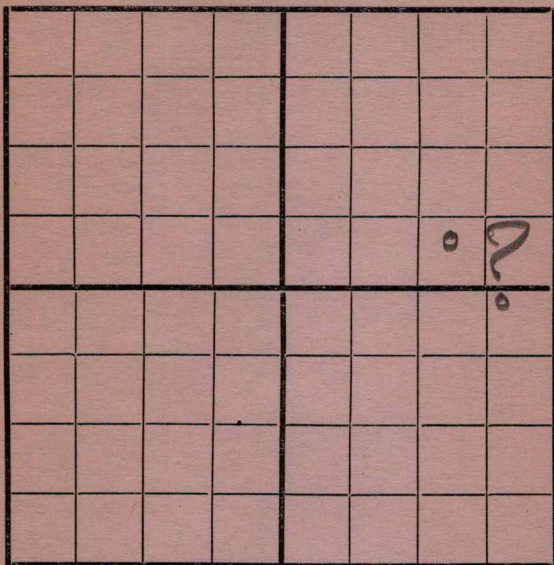

EAST

SOUTH

Location _____
 Rig Up _____
 Drilling and remarks _____

RECORD

Cased _____ in. _____ Ft.
 Sand _____
 Gas _____
 Oil _____
 Total Depth _____

PRODUCTION

1st 24 hrs. Nat. _____
 1st 24 hrs. after shot _____
 Gas _____ Cu. Ft.
 Dry Hole _____
 Abandoned _____

1/1, 191 7 Barclay Scout

Will move
 this Rig to
 different
 location which

Map No. _____ Sec. 21 Twp. 27 R. 4Well No. 15 Perry Farm _____

Company _____

NORTH

WEST

EAST

SOUTH

Location _____

Rig Up _____

Drilling and remarks _____

RECORD

Cased _____ in. _____ Ft.

Sand _____

Gas _____

Oil _____

Total Depth _____

PRODUCTION

1st 24 hrs. Nat. _____

1st 24 hrs. after shot _____

Gas _____ Cu. Ft.

Dry Hole _____

Abandoned _____

Date

1/1, 1912 Cordiff Scout

Map No. _____ Sec. 21 Twp. 27 R. 4
 Well No 15 Penley Farm _____
Campbell Company _____

NORTH

						0	

WEST

EAST

SOUTH

Location _____
 Rig Up _____
 Drilling and remarks _____

Open & Drilling

RECORD

Cased _____ in. _____ Ft.
 Sand _____
 Gas _____
 Oil _____
 Total Depth _____

PRODUCTION

1st 24 hrs. Nat. _____
 1st 24 hrs. after shot _____
 Gas _____ Cu. Ft.
 Dry Hole _____
 Abandoned _____

Date

1/8, 1917 *Cordell* Scout

Map No. _____ Sec. 21 Twp. 27 R. 4
 Well No. 15 _____ Farm _____
Empire Company _____

NORTH

WEST

						0	

EAST

SOUTH

Location _____
 Rig Up _____
 Drilling and remarks _____

RECORD

Cased _____ in. _____ Ft.
 Sand _____
 Gas _____
 Oil _____
 Total Depth _____

PRODUCTION


1st 24 hrs. Nat. _____
 1st 24 hrs. after shot _____
 Gas _____ Cu. Ft.
 Dry Hole _____
 Abandoned _____

Date

1/15, 1917 _____ Scout _____

Map No. _____ Sec. 21 Twp. 27 R. 4
 Well No. 5 Farm _____
Empire Company

NORTH

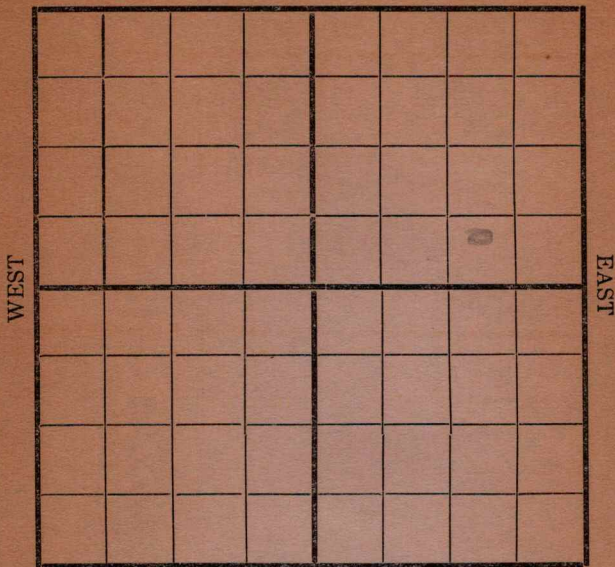

SOUTH

Location _____

Rig Up _____

Drilling and remarks

710

RECORD

Cased _____ in. _____ Ft.

Sand _____

Gas _____

Oil _____

Total Depth _____

PRODUCTION

1st 24 hrs. Nat. _____

1st 24 hrs. after shot _____

Gas _____ Cu. Ft.

Dry Hole _____

Abandoned _____

Date

1/22, 1917 Cordiff Scout

Map No. _____ Sec. 21 Twp. 27 R. 4
Well No. 15 Pennell Farm _____
Engine Company _____

NORTH

[illegible]

SOUTH

Location _____

Rig Up.....

Drilling and remarks

Fishing
710'

RECORD

Cased-----in. -----Ft.

Sand-----

Gas _____

Oil _____

Total Depth_____

PRODUCTION

1st 24 hrs. Nat.

1st 24 hrs. after shot-----

Gas..... Cu. Ft.

Dry Hole _____

Abandoned-----


Date _____

1/29, 1917. Conley Scout

Map No. _____ Sec. 21 Twp. 27 R. 4Well No. 15 Perry _____ Farm
Engine _____ Company

NORTH

WEST

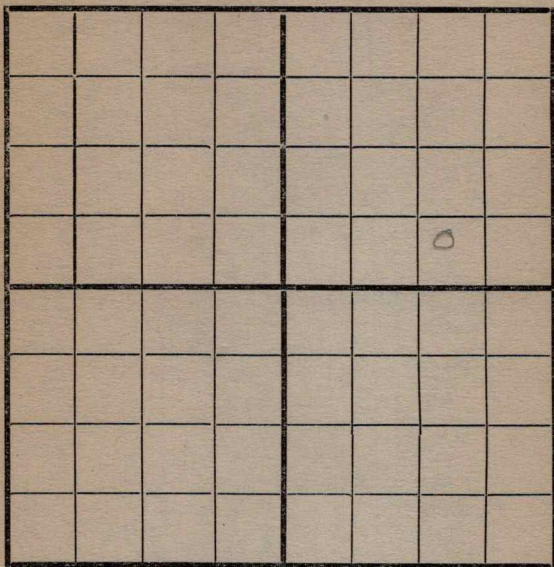

EAST

SOUTH

Location _____

Rig Up _____

Drilling and remarks

1055

RECORD

Cased _____ in. _____ Ft.

Sand _____

Gas _____

Oil _____

Total Depth _____

PRODUCTION

1st 24 hrs. Nat. _____

1st 24 hrs. after shot _____

Gas _____ Cu. Ft.

Dry Hole _____

Abandoned _____

Date


2/5, 1917 Perry _____ Scout

Map No. _____ Sec. 21 Twp. 27 R. 4
 Well No. 15 Penley Farm _____
Empire Company _____

NORTH

WEST

EAST

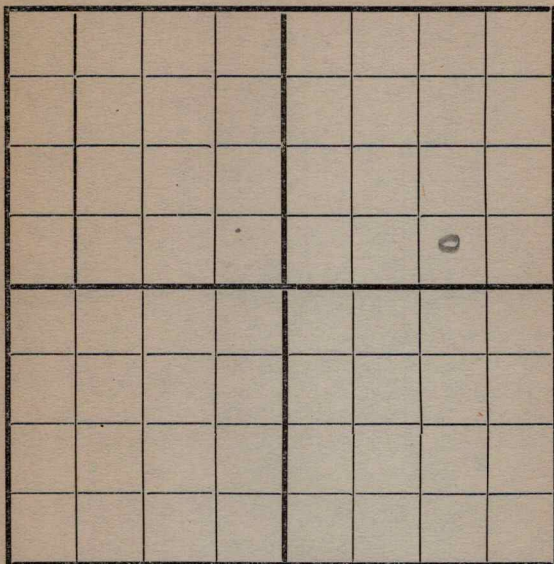

SOUTH

Location _____
 Rig Up _____
 Drilling and remarks _____

1285'

RECORD

Cased _____ in. _____ Ft.
 Sand _____
 Gas _____
 Oil _____
 Total Depth _____

PRODUCTION


1st 24 hrs. Nat. _____
 1st 24 hrs. after shot _____
 Gas _____ Cu. Ft.
 Dry Hole _____
 Abandoned _____

Date

2/2, 1917 Carney Scout

Map No. _____ Sec. 21 Twp. 27 R. 4
Well No. 15 Penley Farm _____
Empire Company _____

NORTH

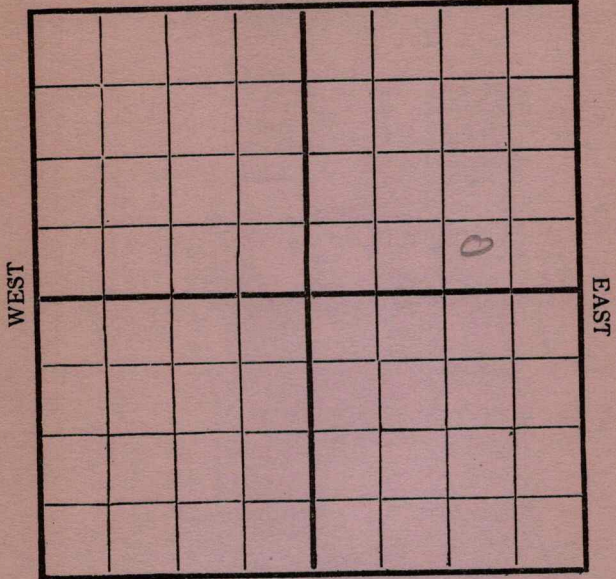

SOUTH

Location _____
Rig Up _____
Drilling and remarks _____

1300'

RECORD


Cased _____ in. _____ Ft.
Sand _____
Gas _____
Oil _____
Total Depth _____

PRODUCTION

1st 24 hrs. Nat. _____
1st 24 hrs. after shot _____
Gas _____ Cu. Ft.
Dry Hole _____
Abandoned _____

Date Aug 19, 1912 J. Corbett Scout

Map No. _____ Sec. 21 Twp. 27 R. 4
 Well No. 15 Pearley Farm _____
Cumprine Company _____
 NORTH

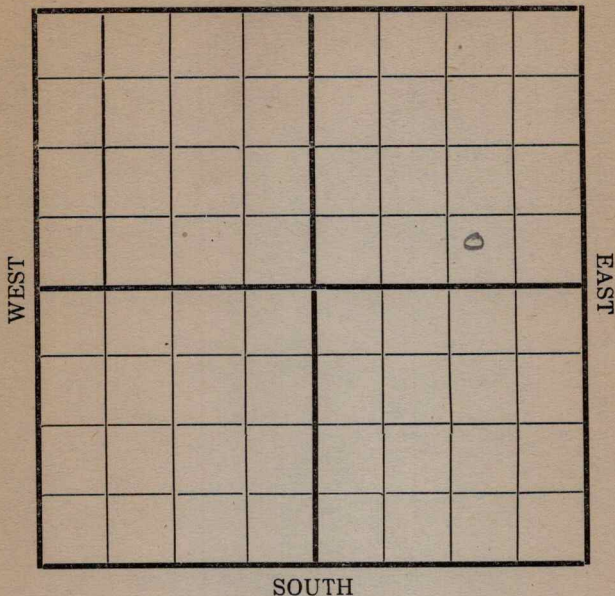

Location _____
 Rig Up _____
 Drilling and remarks _____

1850'

RECORD

Cased _____ in. _____ Ft.
 Sand _____
 Gas _____
 Oil _____
 Total Depth _____

PRODUCTION

1st 24 hrs. Nat. _____
 1st 24 hrs. after shot _____
 Gas _____ Cu. Ft.
 Dry Hole _____
 Abandoned _____


Date _____

2/26 1917 Cumprine Scout

Map No. _____ Sec. 21 Twp. 27 R. 4Well No. 15 Penley Farm _____
Empire Company

NORTH

WEST

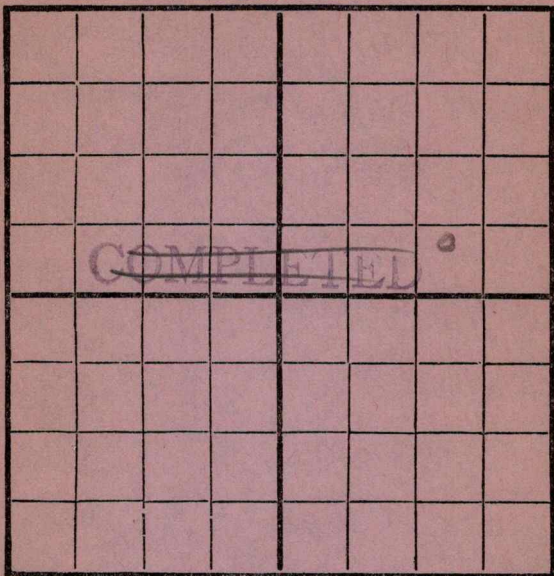

EAST

SOUTH

REMARKS:

Tap sand 1954
 Bottom 1985
 No light well and
 will drill to deep sand
 Drilling 2200

Date


3/5, 1917 Carly Scout

Map No. _____ Sec. 21 Twp. 27 R. 4

Well No. 15 Penley Farm _____
Empire Company _____

NORTH

WEST

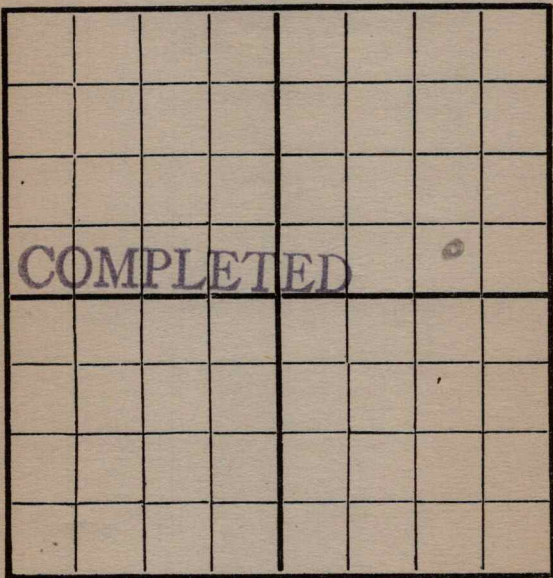

EAST

SOUTH

Location _____
Rig Up _____
Drilling and remarks _____

*Est at
50 bbl*

RECORD

Cased _____ in. _____ Ft.
Sand 2335-2353
Gas _____
Oil _____
Total Depth _____

PRODUCTION

1st 24 hrs. Nat. _____
1st 24 hrs. after shot _____
Gas _____ Cu. Ft.
Dry Hole _____
Abandoned _____

Date 3/12, 1917 Carl J. J. Scout