

Map No. _____ Sec. 31 Twp. 25 R. 5Well No. 44-Robinson Farm __________Omaha Company _____

NORTH

WEST

EAST



SOUTH

Location _____

Rig Up 11-9-16

Drilling Remarks:

Drill = 11/14
950 = 11/27 = 12/4
1130 = 12/11
1535 = 12/18 = 12/28
1635 = 1/1
1700 = 1/8 = U.R.
2040 = 1/15

Drilling Remarks:

RECORD


Cased _____ in _____ Ft.
 Sand _____
 Gas _____
 Oil _____
 Total Depth _____

PRODUCTION

1st 24 hrs. Nat. _____
 1st 24 hrs. after shot _____
 Gas _____ Cu. Ft.
 Dry Hole _____
 Abandoned _____

Map No. _____ Sec. 31 Twp. 25 R. 5

Well No. 18 Robinson Farm _____
Empire Company

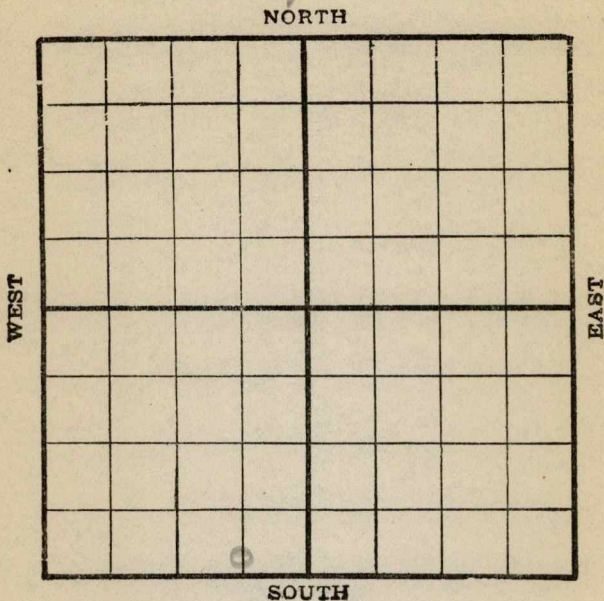

Location _____

Rig up ☒ _____

Drilling and remarks

Deep well

RECORD

Cased _____ in. _____ Ft.

Sand _____

Gas _____

Oil _____

Total Depth _____

PRODUCTION

1st. 24 hrs. Nat. _____

1st 24 hrs. after shot _____

Gas _____ Cu. Ft.

Dry Hole _____

Abandoned _____

Date


10/30, 1916, Lee Scout

Map No. _____ Sec. 31 Twp. 25 R. 5
 Well No. 34 Robinson Farm _____
Engine Company _____

NORTH

WEST

EAST

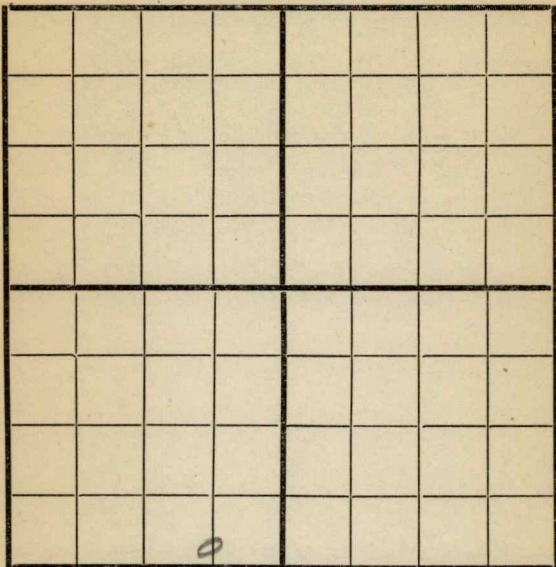

SOUTH

Location _____
 Rig Up ☒ _____
 Drilling and remarks _____

RECORD

Cased _____ in. _____ Ft.
 Sand _____
 Gas _____
 Oil _____
 Total Depth _____

PRODUCTION


1st 24 hrs. Nat. _____
 1st 24 hrs. after shot _____
 Gas _____ Cu. Ft.
 Dry Hole _____
 Abandoned _____

Date

11/9, 1916 B. R. R. R. Scout

Map No. _____ Sec. 31 Twp. 25 R. 5
 Well No. 34 Robinson Farm
Engine Company

NORTH

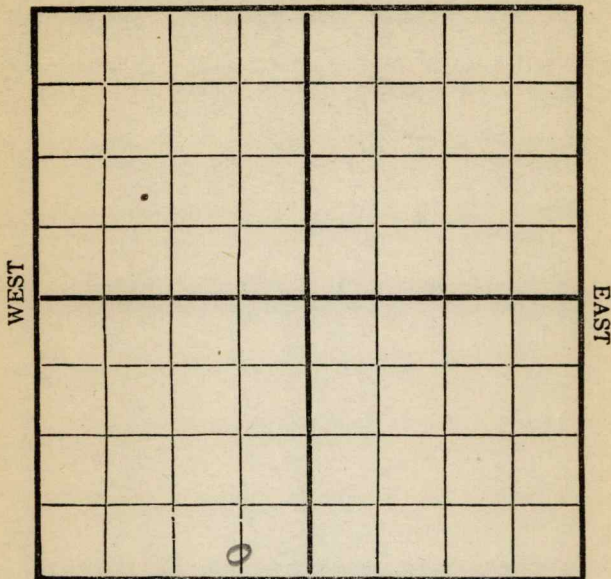

SOUTH

Location _____
 Rig Up ☒
 Drilling and remarks _____

RECORD

Cased _____ in. _____ Ft.
 Sand _____
 Gas _____
 Oil _____
 Total Depth _____


PRODUCTION

1st 24 hrs. Nat. _____
 First 24 hrs. after shot _____
 Gas _____ Cu. Ft.
 Dry Hole _____
 Abandoned _____

Date 11/14, 1916 W. H. O'Leary Scout

Map No. _____ Sec. 31 Twp. 25 R. 5
 Well No. 34 Robinson Farm _____
Enterprise Company _____

NORTH

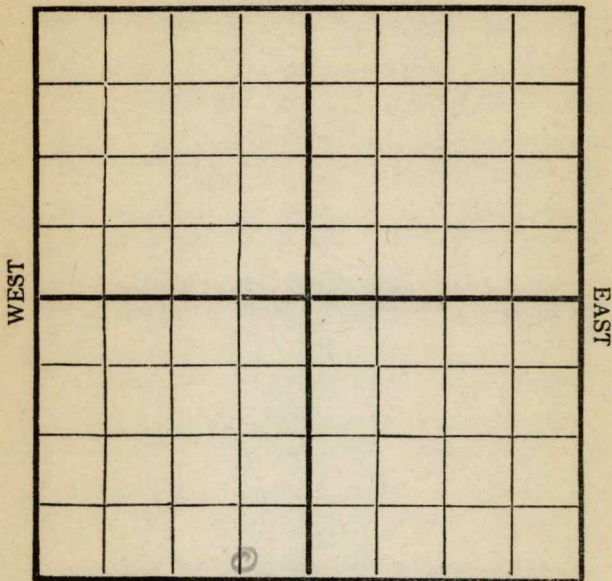

SOUTH

Location _____
 Rig Up _____
 Drilling and remarks _____

400

RECORD

Cased _____ in. _____ Ft.
 Sand _____
 Gas _____
 Oil _____
 Total Depth _____

PRODUCTION

1st 24 hrs. Nat. _____
 1st 24 hrs. after shot _____
 Gas _____ Cu. Ft.
 Dry Hole _____
 Abandoned _____


Date 11/30, 1916 C. C. Card Scout

Map No. _____ Sec. 31 Twp. 25 R. 5
 Well No. 34 Robinson Farm _____
Empire Company _____

NORTH

WEST

EAST

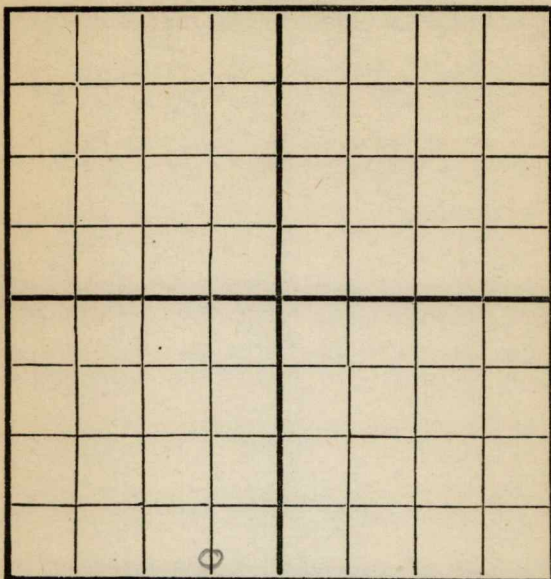

SOUTH

Location _____

Rig Up _____

Drilling and remarks

950

RECORD

Cased _____ in. _____ Ft.

Sand _____

Gas _____

Oil _____

Total Depth _____

PRODUCTION

1st 24 hrs. Nat. _____

1st 24 hrs. after shot _____

Gas _____ Cu. Ft.


Dry Hole _____

Abandoned _____

Date

11/27, 1916 C. O. Duff Scout

Map No. _____ Sec. 31 Twp. 25 R. 5
 Well No. 34 Robinson Farm _____
Empire Company _____
 NORTH

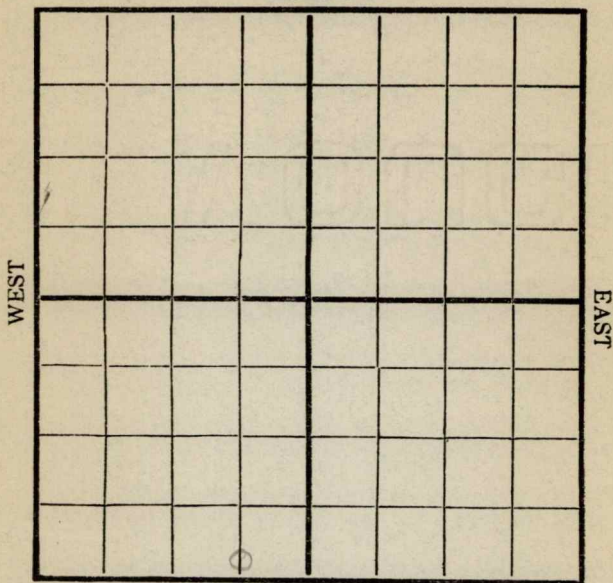

SOUTH

Location _____
 Rig Up _____
 Drilling and remarks _____

Shut Down 950

RECORD

Cased _____ in. _____ Ft.
 Sand _____
 Gas _____
 Oil _____
 Total Depth _____


PRODUCTION

1st 24 hrs. Nat. _____
 1st 24 hrs. after shot _____
 Gas _____ Cu. Ft.
 Dry Hole _____
 Abandoned _____

Date

12/4, 1916, Carly Scout

Map No. _____ Sec. 31 Twp. 25 R. 5
 Well No. 24 Robinson Farm _____
Empire Company _____
 NORTH

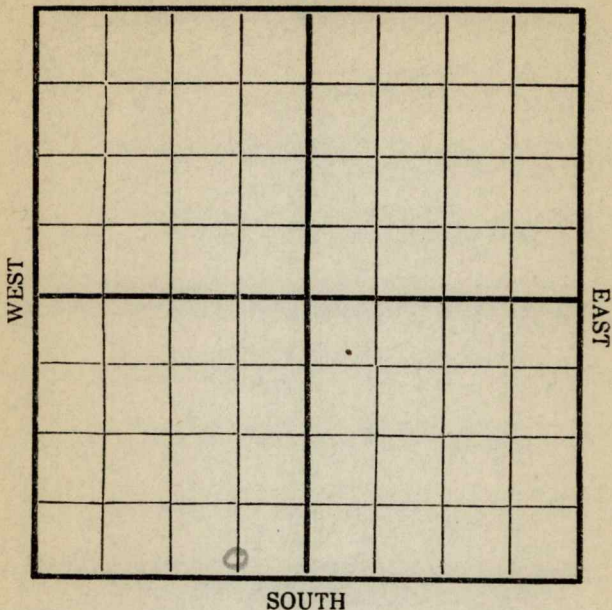

SOUTH

Location _____

Rig Up _____

Drilling and remarks

1130'

RECORD

Cased _____ in. _____ Ft.

Sand _____

Gas _____

Oil _____

Total Depth _____

PRODUCTION

1st 24 hrs. Nat. _____

1st 24 hrs. after shot _____

Gas _____ Cu. Ft.

Dry Hole _____


Abandoned _____

Date

12/11, 1916, Condy Scout

Map No. _____ Sec. 31 Twp. 25 R. 5
 Well No. 24 Robinson Farm
Empire Company

NORTH

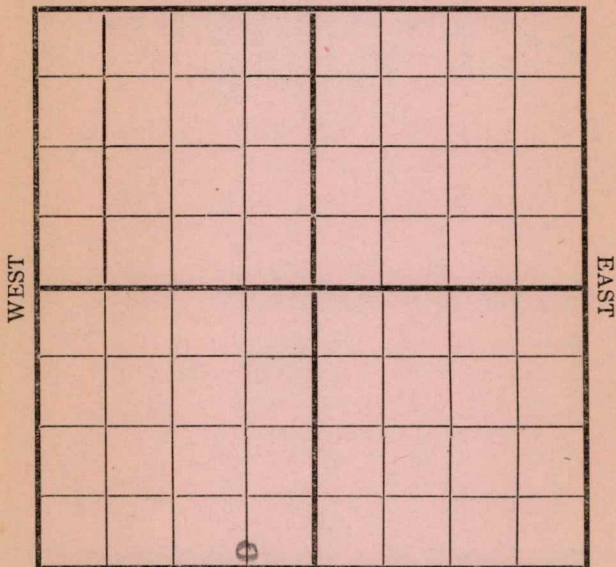

SOUTH

Location _____
 Rig Up _____
 Drilling and remarks _____

1535

RECORD


Cased _____ in. _____ Ft.
 Sand _____
 Gas _____
 Oil _____
 Total Depth _____

PRODUCTION

1st 24 hrs. Nat. _____
 1st 24 hrs. after shot _____
 Gas _____ Cu. Ft.
 Dry Hole _____
 Abandoned _____

Date 12/18, 1916 Cordell Scout

Map No. _____ Sec. 31 Twp. 25 R. 5
 Well No. 24 Robinson Farm
Empire Company
 NORTH

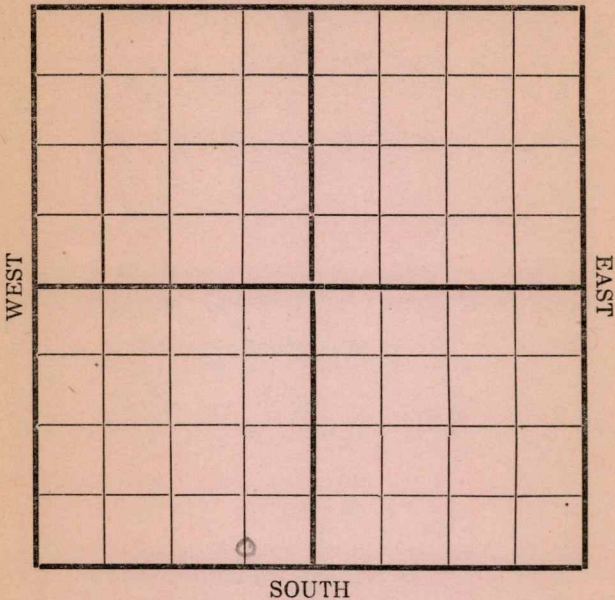

Location _____ Rig Up _____ Drilling and remarks <i>Shut Down</i> <i>at 1535</i>	RECORD Cased _____ in. _____ Ft. Sand _____ Gas _____ Oil _____ Total Depth _____ PRODUCTION 1st 24 hrs. Nat. _____ 1st 24 hrs. after shot _____ Gas _____ Cu. Ft. Dry Hole _____ Abandoned _____
--	---

Date 12/28 1916 Cordiff Scout

Map No. _____ Sec. 31 Twp. 25 R. 5Well No. 24 Robinson Farm

_____ Company

NORTH

WEST

EAST

SOUTH

Location _____

Rig Up _____

Drilling and remarks

1635'

RECORD

Cased _____ in. _____ Ft.

Sand _____

Gas _____

Oil _____

Total Depth _____

PRODUCTION

1st 24 hrs. Nat. _____

1st 24 hrs. after shot _____

Gas _____ Cu. Ft.

Dry Hole _____

Abandoned _____

Date

1/1, 1917Carney Scout

Map No. _____ Sec. 31 Twp. 25 R. 5
 Well No. 24 Robinson Farm _____
Amey Company _____

NORTH

WEST

EAST

SOUTH

Location _____
 Rig Up _____
 Drilling and remarks _____

N. R. at
1700

RECORD

Cased _____ in. _____ Ft.
 Sand _____
 Gas _____
 Oil _____
 Total Depth _____

PRODUCTION

1st 24 hrs. Nat. _____
 First 24 hrs. after shot _____
 Gas _____ Cu. Ft.
 Dry Hole _____
 Abandoned _____

Date

1/8, 1917 Carly Scout _____

Map No. _____ Sec. 31 Twp. 25 R. 5Well No 24 Robinson Farm _____

_____ Company _____

NORTH

WEST

EAST

SOUTH

Location _____

Rig Up _____

Drilling and remarks

2300'

RECORD

Cased _____ in. _____ Ft.

Sand _____

Gas _____

Oil _____

Total Depth _____

PRODUCTION

1st 24 hrs. Nat. _____

1st 24 hrs. after shot _____

Gas _____ Cu. Ft.

Dry Hole _____


Abandoned _____

Date

1/22, 1917 Condeff Scout

Map No. _____ Sec. 31 Twp. 25 R. 5
 Well No. 24 Robinson Farm
Engine Company

NORTH

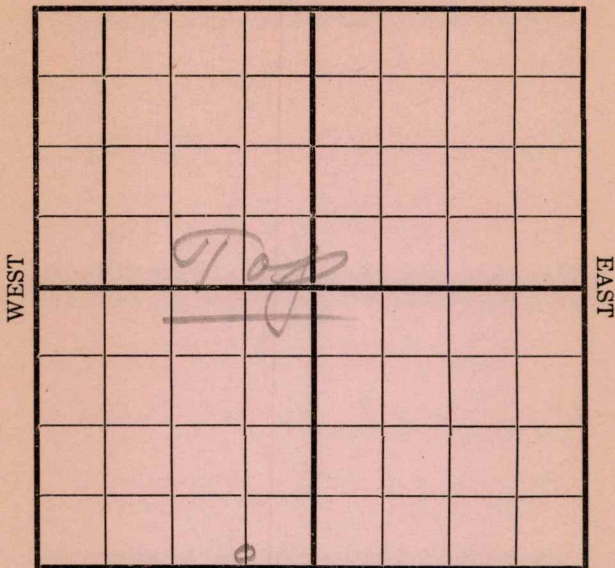

SOUTH

Location _____
 Rig Up _____
 Drilling and remarks _____

Top sand
2440'

RECORD

Cased _____ in. _____ Ft.
 Sand _____
 Gas _____
 Oil _____
 Total Depth _____

PRODUCTION

1st 24 hrs. Nat. _____
 1st 24 hrs. after shot _____
 Gas _____ Cu. Ft.
 Dry Hole _____
 Abandoned _____


Date 1/29, 1917 Carley Scout

Map No. _____ Sec. 31 Twp. 25 R. 5
 Well No. 24 Robinson Farm
Carpine Company

NORTH

WEST

EAST

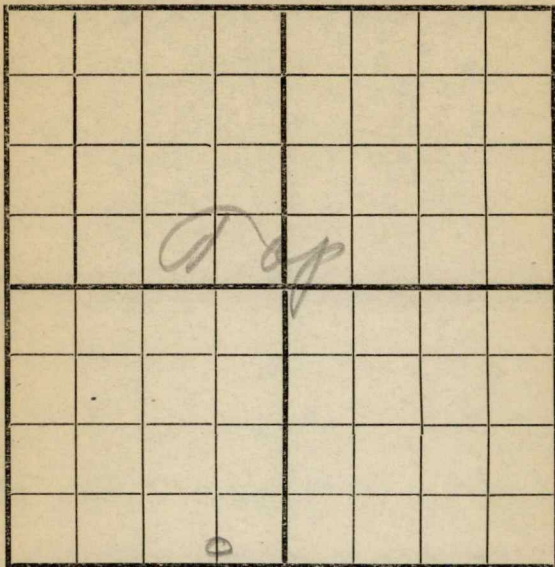

SOUTH

Location _____
 Rig Up _____
 Drilling and remarks _____

RECORD

Cased _____ in. _____ Ft.
 Sand 2440
 Gas _____
 Oil _____
 Total Depth _____

PRODUCTION

1st 24 hrs. Nat. _____
 1st 24 hrs. after shot _____
 Gas _____ Cu. Ft.
 Dry Hole _____
 Abandoned _____

Date

285, 191 7 Carpine Scout

Map No. _____ Sec. 31 Twp. 25 R. 5Well No. 24 Robinson Farm __________Empire_____
Company

NORTH

WEST

EAST

COMPLETED

SOUTH

Location _____

Rig Up _____

Drilling and remarks

Estimated150 Bbls

RECORD

Cased _____ in. _____ Ft.

Sand 2456-2473

Gas _____

Oil _____

Total Depth _____

PRODUCTION

1st 24 hrs. Nat. _____

1st 24 hrs. after shot _____

Gas _____ Cu. Ft.

Dry Hole _____

Abandoned _____

Date

2/12, 1917 C. A. C. J. Scout