


Map No. _____ Sec. 31 Twp. 25 R. 5
 Well No. B5 Robinson Farm _____
Empire Company _____

NORTH

WEST

EAST

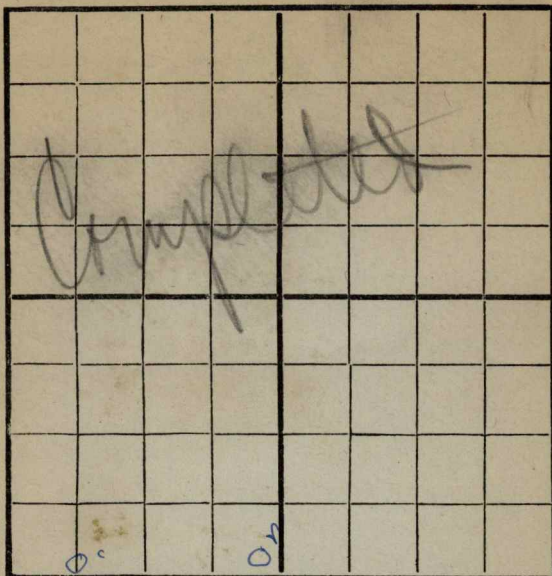

SOUTH

Location 2 ✓Rig Up 11-14-16

Drilling Remarks:

Drilling Remarks:

Dr. H. = 11/27 = 12/4 12/11 = 12/18 = 12/28 = 11/1
1/8 24/15


RECORD

PRODUCTION

Cased _____ in _____ Ft.
 Sand _____
 Gas _____
 Oil _____
 Total Depth _____

1st 24 hrs. Nat. _____
 1st 24 hrs. after shot _____
 Gas _____ Cu. Ft.
 Dry Hole _____
 Abandoned _____

Map No. _____ Sec. 31 Twp. 25 R. 3
 Well No. 35 Robinson Farm
Empire Company
 NORTH

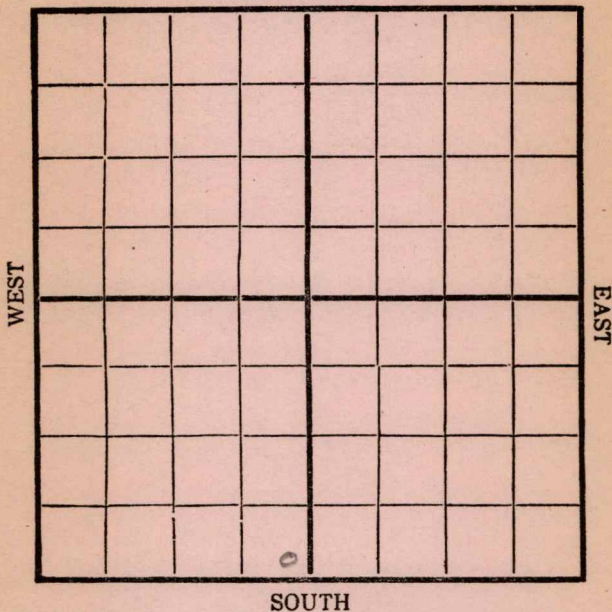

SOUTH

Location ✓
 Rig Up _____
 Drilling and remarks _____

RECORD

Cased _____ in. _____ Ft.
 Sand _____
 Gas _____
 Oil _____
 Total Depth _____

PRODUCTION

1st 24 hrs. Nat. _____
 First 24 hrs. after shot _____
 Gas _____ Cu. Ft.
 Dry Hole _____
 Abandoned _____

Date


11/14 1916 6 Secord Scout

Map No. _____ Sec. 31 Twp. 25 R. 5
 Well No. 35 Robinson Farm _____
Engine Company _____

NORTH

WEST

EAST

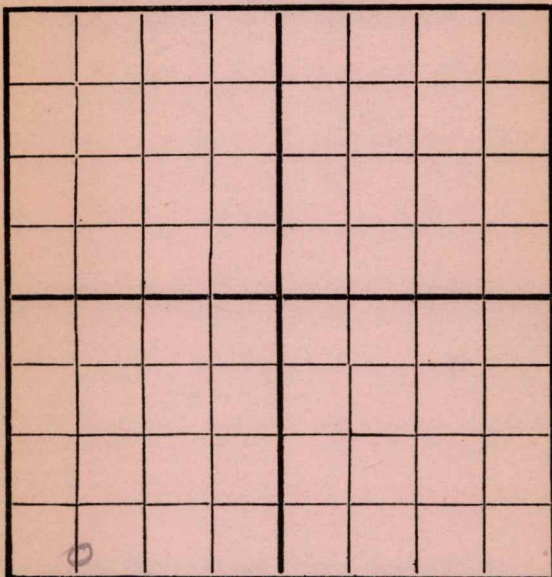

SOUTH

Location _____
 Rig Up ☒
 Drilling and remarks _____

RECORD

Cased _____ in. _____ Ft.
 Sand _____
 Gas _____
 Oil _____
 Total Depth _____

PRODUCTION

1st 24 hrs. Nat. _____
 1st 24 hrs. after shot _____
 Gas _____ Cu. Ft.
 Dry Hole _____
 Abandoned _____

Date

11/20, 1916 Cardiff Scout

Map No. _____ Sec. 31 Twp. 25 R. 5
 Well No. 35 Robinson Farm
Engine Company

NORTH

WEST

EAST

SOUTH

Location _____

Rig Up ☒ _____

Drilling and remarks _____

RECORD

Cased _____ in. _____ Ft.

Sand _____

Gas _____

Oil _____

Total Depth _____

PRODUCTION

1st 24 hrs. Nat. _____

1st 24 hrs. after shot _____

Gas _____ Cu. Ft.


Dry Hole _____

Abandoned _____

Date

11/27, 1916 Cordy Scout

Map No. _____ Sec. 31 Twp. 25 R. 5
 Well No. 35 Robinson Farm _____
Empire Company _____
 NORTH

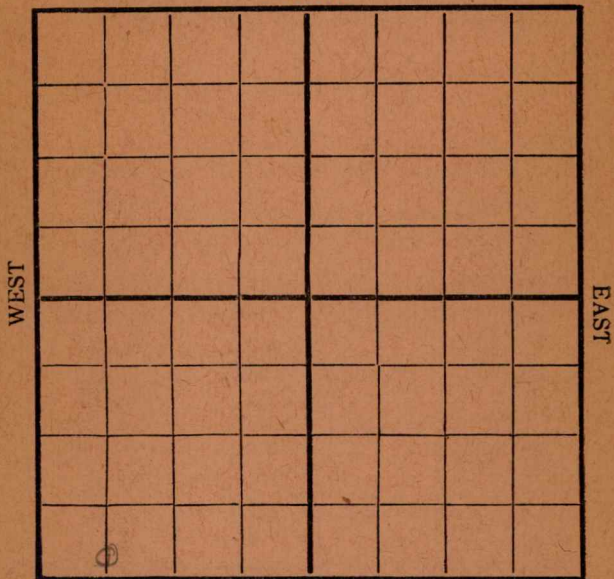

SOUTH

Location _____
 Rig Up ☒ _____
 Drilling and remarks _____

RECORD

Cased _____ in. _____ Ft.
 Sand _____
 Gas _____
 Oil _____
 Total Depth _____

PRODUCTION

1st 24 hrs. Nat. _____
 1st 24 hrs. after shot _____
 Gas _____ Cu. Ft.
 Dry Hole _____
 Abandoned _____

Date


12/4, 1916, Cordiff Scout

Map No. _____ Sec. 31 Twp. 25 R. 5Well No. 25 Robinson Farm __________Enterprise Company _____

NORTH

WEST

EAST

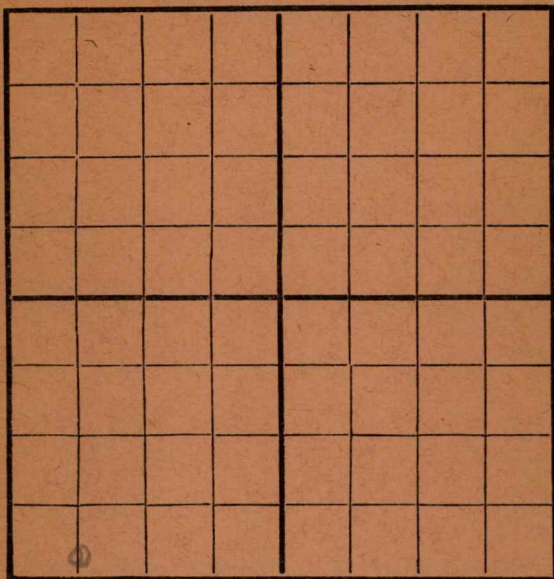

SOUTH

Location _____ ✓

Rig Up _____

Drilling and remarks _____

RECORD

Cased _____ in. _____ Ft.

Sand _____

Gas _____

Oil _____

Total Depth _____

PRODUCTION

1st 24 hrs. Nat. _____

1st 24 hrs. after shot _____

Gas _____ Cu. Ft.

Dry Hole _____


Abandoned _____

Date

10/11, 1916, Cordell Scout

Map No. _____ Sec. 31 Twp. 25 R. 5
 Well No. 25 Robinson Farm
Engine Company

NORTH

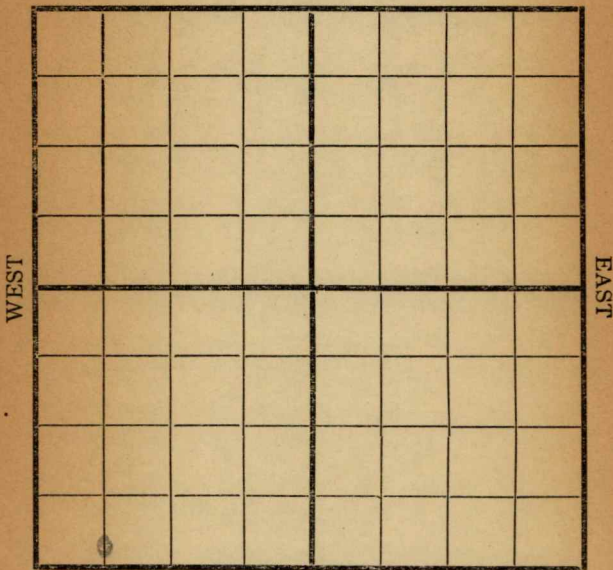

SOUTH

Location _____
 Rig Up ☒ _____
 Drilling and remarks _____

RECORD

Cased _____ in. _____ Ft.
 Sand _____
 Gas _____
 Oil _____
 Total Depth _____

PRODUCTION

1st 24 hrs. Nat. _____
 1st 24 hrs. after shot _____
 Gas _____ Cu. Ft.
 Dry Hole _____
 Abandoned _____

Date

12/18, 1916 Carly Scout

Map No. _____ Sec. 31 Twp. 25 R. 5
 Well No. 25 Robinson Farm _____
Cummins Company

NORTH

WEST

EAST

SOUTH

Location _____
 Rig Up ☒ _____
 Drilling and remarks _____

RECORD

Cased _____ in. _____ Ft.
 Sand _____
 Gas _____
 Oil _____
 Total Depth _____

PRODUCTION

1st 24 hrs. Nat. _____
 1st 24 hrs. after shot _____
 Gas _____ Cu. Ft.
 Dry Hole _____
 Abandoned _____

Date


12/28/16 1916 Cordell Scout

Map No. _____ Sec. 31 Twp. 25 R. 5
 Well No. 25 Robinson Farm _____
Empire Company _____

NORTH

WEST

EAST

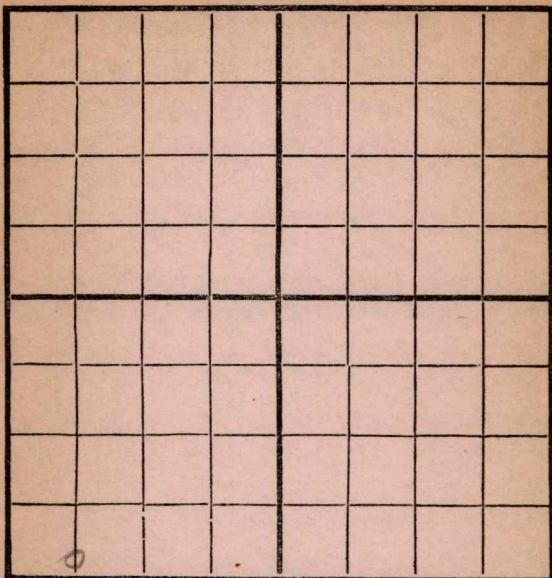

SOUTH

Location _____
 Rig Up ☒ _____
 Drilling and remarks _____

RECORD

Cased _____ in. _____ Ft.
 Sand _____
 Gas _____
 Oil _____
 Total Depth _____

PRODUCTION

1st 24 hrs. Nat. _____
 First 24 hrs. after shot _____
 Gas _____ Cu. Ft.
 Dry Hole _____
 Abandoned _____

Date

1/8, 191 7 Conley Scout

Map No. _____ Sec. 31 Twp. 25 R. 5
Well No. 35 Robinson Farm
Empire Company

NORTH

WEST

EAST

SOUTH

Location _____
Rig Up _____
Drilling and remarks _____

RECORD

Cased _____ in. _____ Ft.
 Sand _____
 Gas _____
 Oil _____
 Total Depth _____

PRODUCTION

1st 24 hrs. Nat. _____
 1st 24 hrs. after shot _____
 Gas _____ Cu. Ft. _____
 Dry Hole _____
 Abandoned _____

Date _____

191 Scout

Map No. _____ Sec. 31 Twp. 25 R. 5
 Well No. 25 Robinson Farm
Empire Company

NORTH

WEST

EAST

SOUTH

Location _____
 Rig Up ☒
 Drilling and remarks _____

RECORD

Cased _____ in. _____ Ft.
 Sand _____
 Gas _____
 Oil _____
 Total Depth _____

PRODUCTION


1st 24 hrs. Nat. _____
 1st 24 hrs. after shot _____
 Gas _____ Cu. Ft.
 Dry Hole _____
 Abandoned _____

Date

1/29, 1917 Carbide Scout

Map No. _____ Sec. 31 Twp. 25 R. 5
 Well No. 25 Robinson Farm _____
Empire Company _____

NORTH

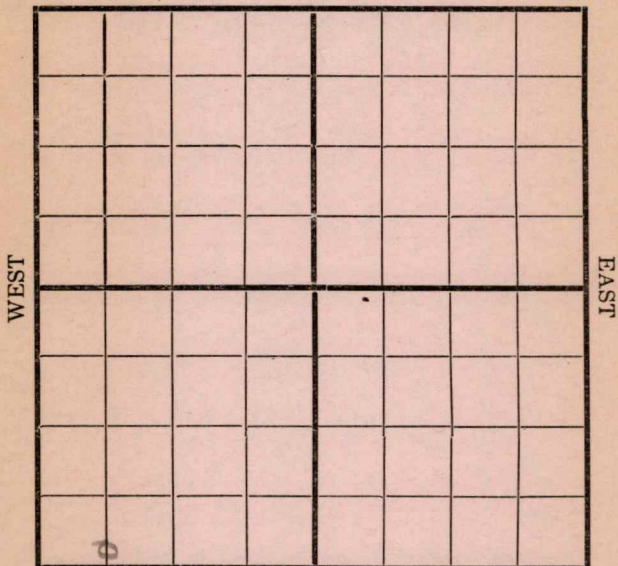

SOUTH

Location _____
 Rig Up ☒ _____
 Drilling and remarks _____

RECORD

Cased _____ in. _____ Ft.
 Sand _____
 Gas _____
 Oil _____
 Total Depth _____

PRODUCTION


1st 24 hrs. Nat. _____
 1st 24 hrs. after shot _____
 Gas _____ Cu. Ft.
 Dry Hole _____
 Abandoned _____

Date

2/5, 1917 Candy Scout

Map No. _____ Sec. 31 Twp. 25 R. 5
 Well No. 25 Robinson Farm _____
Empire Company

NORTH

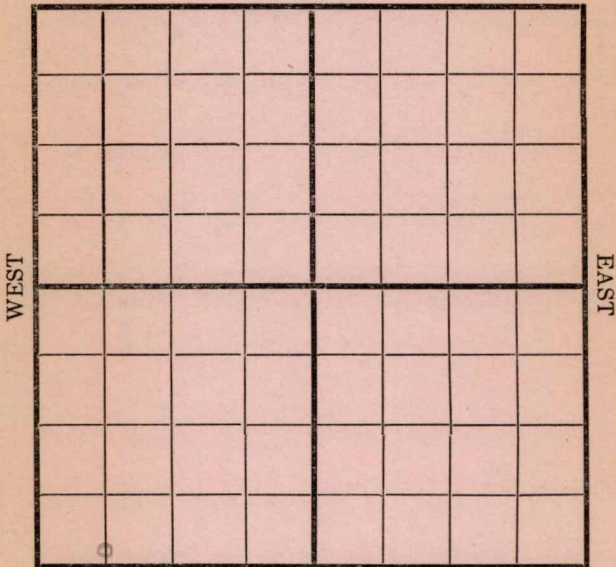

SOUTH

Location _____
 Rig Up ☒ _____
 Drilling and remarks _____

RECORD

Cased _____ in. _____ Ft.
 Sand _____
 Gas _____
 Oil _____
 Total Depth _____

PRODUCTION

1st 24 hrs. Nat. _____
 1st 24 hrs. after shot _____
 Gas _____ Cu. Ft.
 Dry Hole _____
 Abandoned _____


Date 9/12, 1917 Cand Scout

Map No. _____ Sec. 31 Twp. 25 R. 5
 Well No. 25 Robinson Farm
Empire Company

NORTH

WEST

EAST

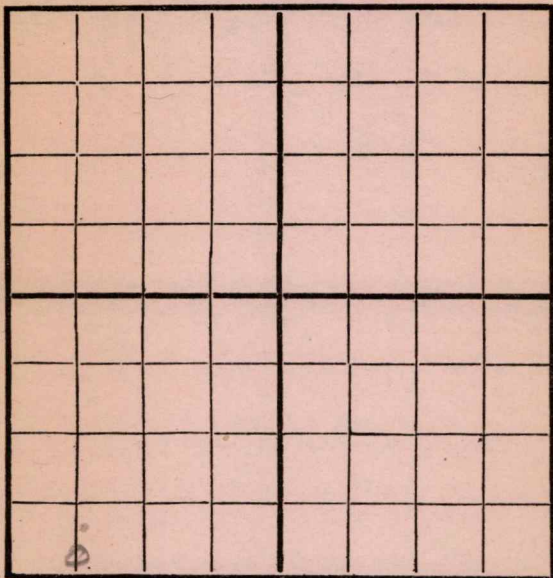

SOUTH

Location _____
 Rig Up _____
 Drilling and remarks _____

RECORD

Cased _____ in. _____ Ft.
 Sand _____
 Gas _____
 Oil _____
 Total Depth _____


PRODUCTION

1st 24 hrs. Nat. _____
 1st 24 hrs. after shot _____
 Gas _____ Cu. Ft.
 Dry Hole _____
 Abandoned _____

Date 9/19, 1917 Carroll Scout

Map No. _____ Sec. 31 Twp. 25 R. 5
 Well No. 25 Robinson Farm
Empire Company

NORTH

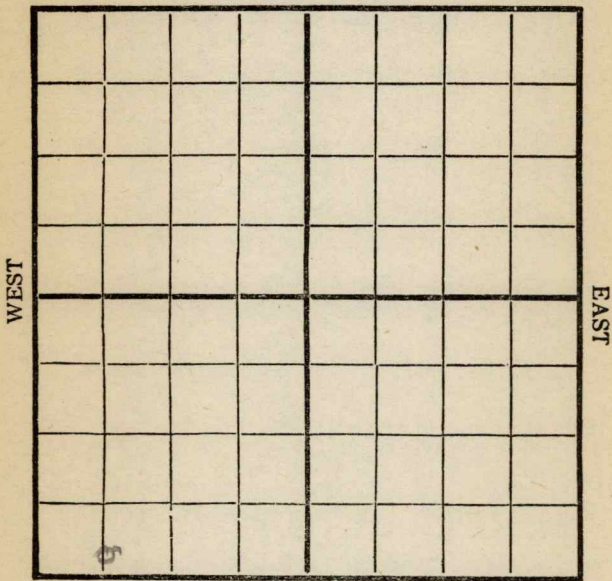

SOUTH

Location _____
 Rig Up _____
 Drilling and remarks

750

RECORD

Cased _____ in. _____ Ft.
 Sand _____
 Gas _____
 Oil _____
 Total Depth _____

PRODUCTION


1st 24 hrs. Nat. _____
 First 24 hrs. after shot _____
 Gas _____ Cu. Ft.
 Dry Hole _____
 Abandoned _____

Date

Feb 7 1917 Carroll Scout

Map No. _____ Sec. 31 Twp. 25 R. 5Well No. 25 Robinson Farm
Engine Company

NORTH

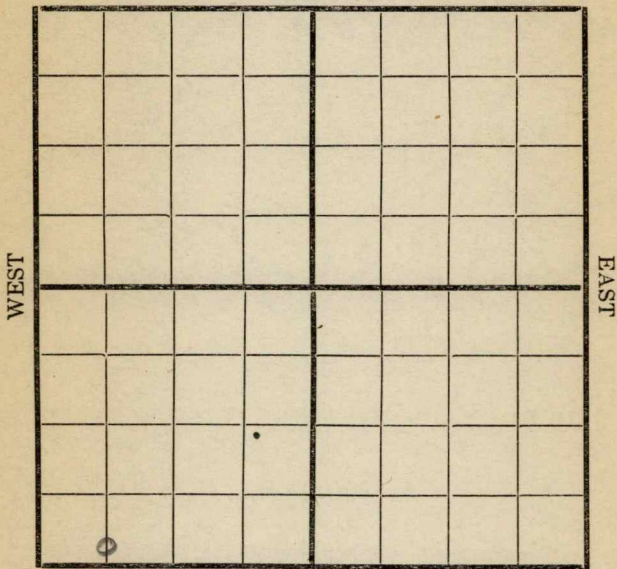

SOUTH

Location _____

Rig Up _____

Drilling and remarks

1000'

RECORD

Cased _____ in. _____ Ft.

Sand _____

Gas _____

Oil _____

Total Depth _____

PRODUCTION

1st 24 hrs. Nat. _____

1st 24 hrs. after shot _____

Gas _____ Cu. Ft.

Dry Hole _____


Abandoned _____

Date

3-5- 191 7 Carley Scout

Map No. _____ Sec. 31 Twp. 25 R. 5Well No. 25 Robinson FarmEmpire Company

NORTH

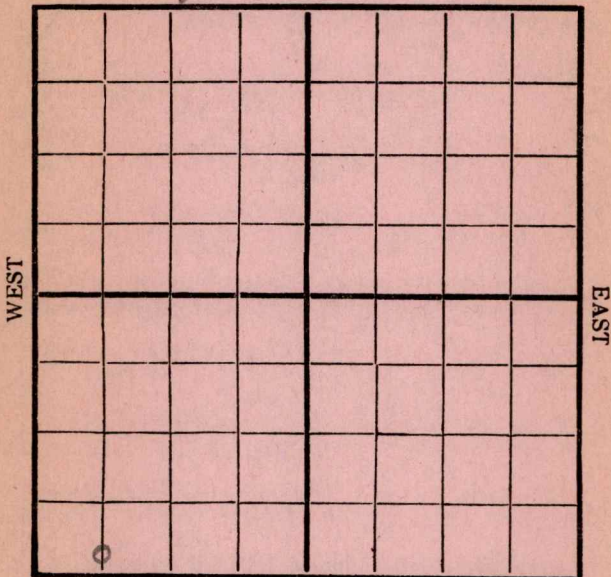

SOUTH

REMARKS:

1375

Date

3/12, 1917 Carley Scout

Map No. _____ Sec. 31 Twp. 25 R. 5Well No. 25 Robinson FarmCummins Company

NORTH

WEST

EAST

SOUTH

Location _____

Rig Up _____

Drilling and remarks

1650'

RECORD

Cased _____ in. _____ Ft.

Sand _____

Gas _____

Oil _____

Total Depth _____

PRODUCTION

1st 24 hrs. Nat. _____

1st 24 hrs. after shot _____

Gas _____ Cu. Ft.

Dry Hole _____


Abandoned _____

Date

3/21, 1917 Cordis Scout

Map No. _____ Sec. 31 Twp. 25 R. 5
Well No. 25 Robinson Farm _____
Empire Company _____

NORTH

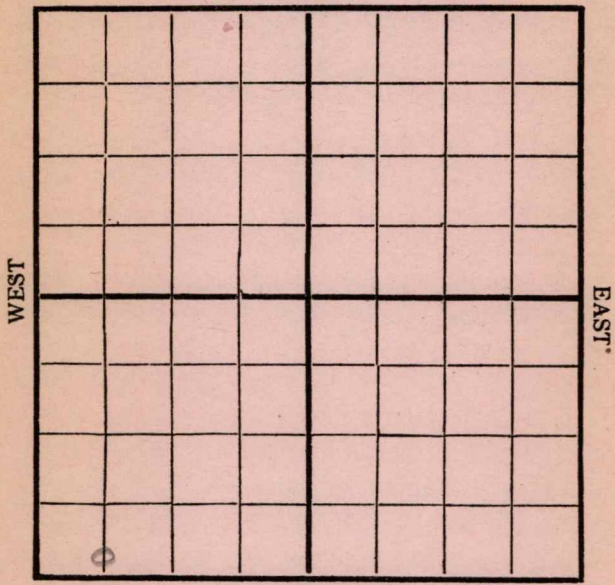

SOUTH

Location _____
Rig Up _____
Drilling and remarks _____

1785

RECORD

Cased _____ in. _____ Ft.
Sand _____
Gas _____
Oil _____
Total Depth _____

PRODUCTION

1st 24 hrs. Nat. _____
1st 24 hrs. after shot _____
Gas _____ Cu. Ft.
Dry Hole _____
Abandoned _____


Date 3/26 191 2 Co. L. S. Scout

Map No. _____ Sec. 31 Twp. 25 R. 5
 Well No. 25 Robinson Farm _____
Empire Company _____

NORTH

WEST

EAST

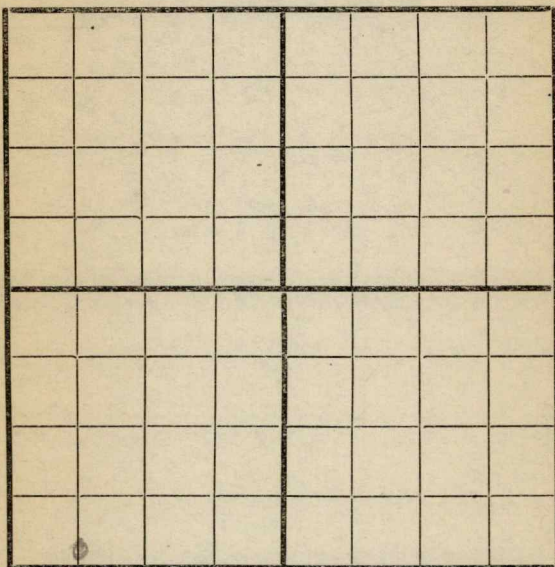

SOUTH

Location _____

Rig Up _____

Drilling and remarks

1800'

RECORD

Cased _____ in. _____ Ft.

Sand _____

Gas _____

Oil _____

Total Depth _____

PRODUCTION

1st 24 hrs. Nat. _____

1st 24 hrs. after shot _____

Gas _____ Cu. Ft.

Dry Hole _____

Abandoned _____

Date

4/5, 1917 Carroll Scout

Map No. _____ Sec. 31 Twp. 25 R. 5
 Well No. 25 Robinson Farm _____
Empire Company _____

NORTH

WEST

EAST

SOUTH

Location _____
 Rig Up _____
 Drilling and remarks

Fishing
1800'

RECORD

Cased _____ in. _____ Ft.
 Sand _____
 Gas _____
 Oil _____
 Total Depth _____


PRODUCTION

1st 24 hrs. Nat. _____
 1st 24 hrs. after shot _____
 Gas _____ Cu. Ft.
 Dry Hole _____
 Abandoned _____

Date

4/11, 191 7 Candell Scout

Map No. _____ Sec. 31 Twp. 25 R. 5
 Well No. 25 Robinson Farm
Engine Company
 NORTH

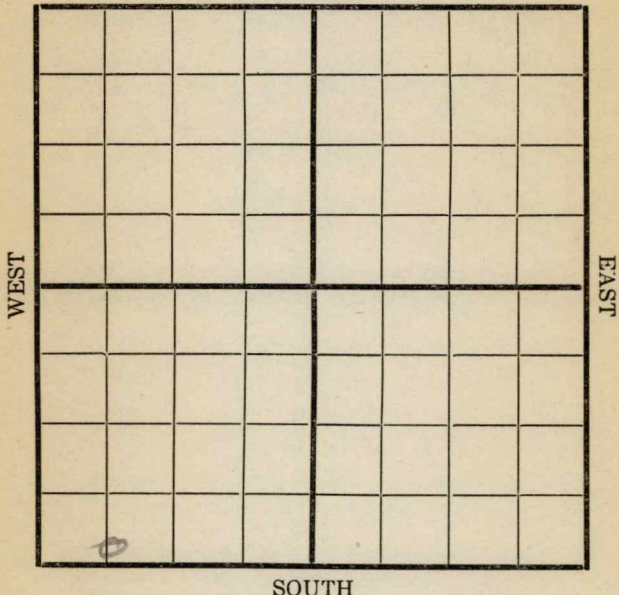

SOUTH

Location _____
 Rig Up _____
 Drilling and remarks

1900'

RECORD

Cased _____ in. _____ Ft.
 Sand _____
 Gas _____
 Oil _____
 Total Depth _____


PRODUCTION

1st 24 hrs. Nat. _____
 1st 24 hrs. after shot _____
 Gas _____ Cu. Ft.
 Dry Hole _____
 Abandoned _____

Date 4/9, 1917 Carly Scout

Map No. _____ Sec. 31 Twp. 25 R. 5
 Well No. 25 Robinson Farm
Engine Company

NORTH

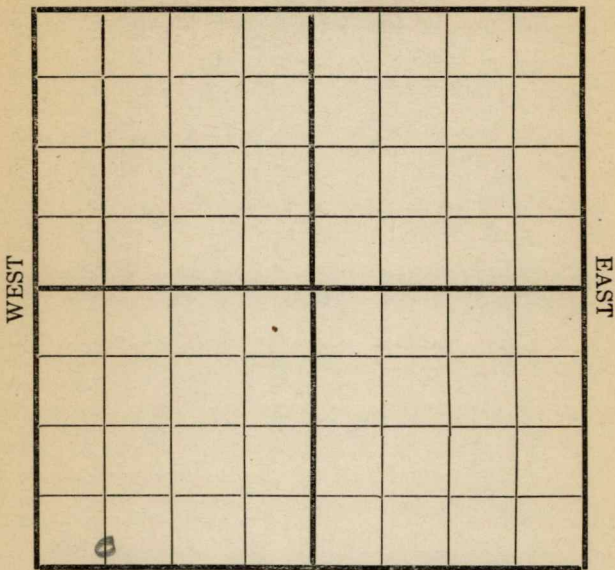

SOUTH

Location _____
 Rig Up _____
 Drilling and remarks

2060

RECORD

Cased _____ in. _____ Ft.
 Sand _____
 Gas _____
 Oil _____
 Total Depth _____

PRODUCTION

1st 24 hrs. Nat. _____
 1st 24 hrs. after shot _____
 Gas _____ Cu. Ft.
 Dry Hole _____
 Abandoned _____

Date

APR 26 1917

191

Cordy


Scout

Map No. _____ Sec. 31 Twp. 25 R. 5
 Well No 25 Roberson Farm _____
Emp Company _____

NORTH

WEST

EAST

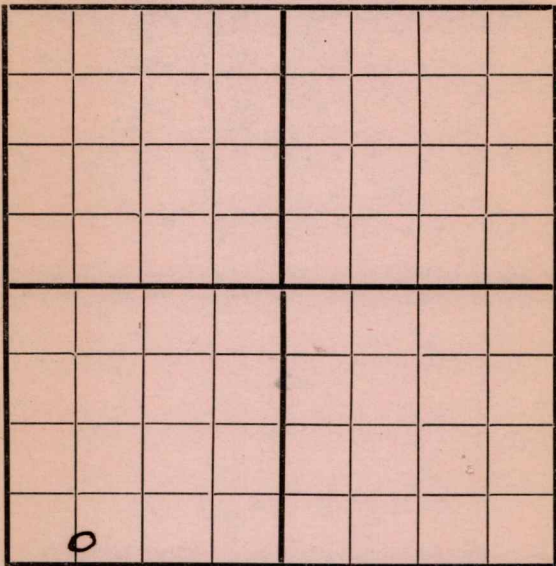

SOUTH

Location _____
 Rig Up _____
 Drilling and remarks _____

RECORD

Cased _____ in. _____ Ft.
 Sand _____
 Gas _____
 Oil _____
 Total Depth _____

PRODUCTION

1st 24 hrs. Nat. _____
 1st 24 hrs. after shot _____
 Gas _____ Cu. Ft.
 Dry Hole _____
 Abandoned _____

Date

5/5, 1917 Dorper Scout

Map No. _____ Sec. 31 Twp. 25 R. 5
 Well No. 25 Robinson Farm
Emp. Company
 NORTH

WEST EAST

SOUTH

Location _____

Rig up _____

Drilling and remarks:

D-2540'

RECORD

Cased _____ in. _____ Ft.

Sand _____

Gas _____

Oil _____

Total Depth _____

PRODUCTION

1st 24 hrs. Nat. _____

1st 24 hrs. after shot _____

Gas _____ Cu. Ft.

Dry Hole _____

Abandoned _____

Date

5/12/1917, Brocker Scout

Map No. _____ Sec. 31 Twp. 25 R. 5
 Well No. 25 Robinson Farm _____
Emp. Company _____
 NORTH

WEST EAST

SOUTH

Location _____

Rig up _____

Drilling and remarks:

IS. 2464,
Pulling
Pipe.

RECORD

Cased _____ in. _____ Ft.

Sand _____

Gas _____

Oil _____

Total Depth _____

PRODUCTION

1st 24 hrs. Nat. _____

1st 24 hrs. after shot _____

Gas _____ Cu. Ft.

Dry Hole _____

Abandoned _____

Date


5/19, 1917, Crocker Scout

Map No. _____ Sec. 31 Twp. 25 R. 5Well No. 25 Robinson Farm __________Emp. Company _____

NORTH

WEST

EAST

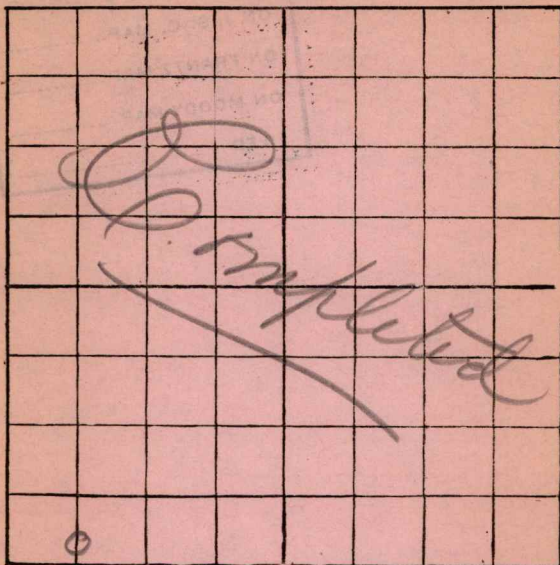

SOUTH

Location _____

Rig up _____

Drilling and remarks:

RECORD

Cased _____ in. _____ Ft.

Sand _____

Gas _____

Oil 2459-2472Total Depth 2472

PRODUCTION

1st 24 hrs. Nat. _____

1st 24 hrs. after shot _____

Gas _____ Cu. Ft.

Dry Hole _____

Abandoned _____

Date

5/26, 1917, Crocker Scout