

Butler


KANSAS
SE

Section 6 Township 23 24 Range 5E

Well No. #1 Claassen

Company Morrison Drlg.

NORTH

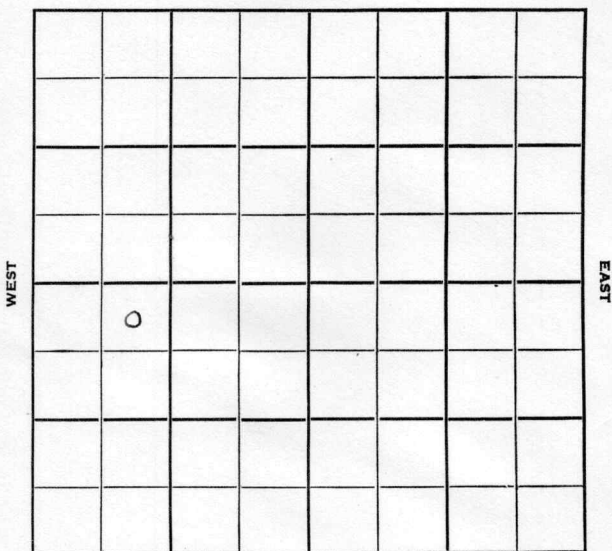

SOUTH

Butler

KANSAS

Sec. 6 Twp. 24 R. 5E ✓

Well No. #1 Claassen Farm

Morrison Drlg. Company


Morrison Drlg. - Contr. Contractor

330' Ft. from N. Line

_____ Ft. from S. Line

_____ Ft. from E. Line

990' Ft. from W. Line

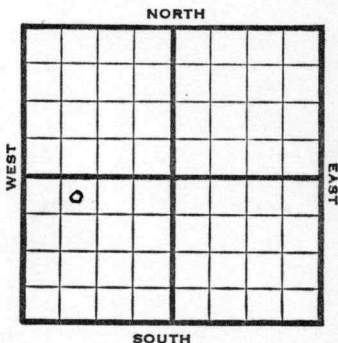

NE NW SW

1950

Elev 1468'

REPORT

11/29

Drlg.

12/20

Spud 11-17-50

12" @ 155

Miss 2438

TD 2458

7" @ 2438

Comp 20 bopd

Completed

COMPLETED

