


Section 6 Township 24 Range 5 E

Well No. # 2 Claassen

Company Morrison Drlg.

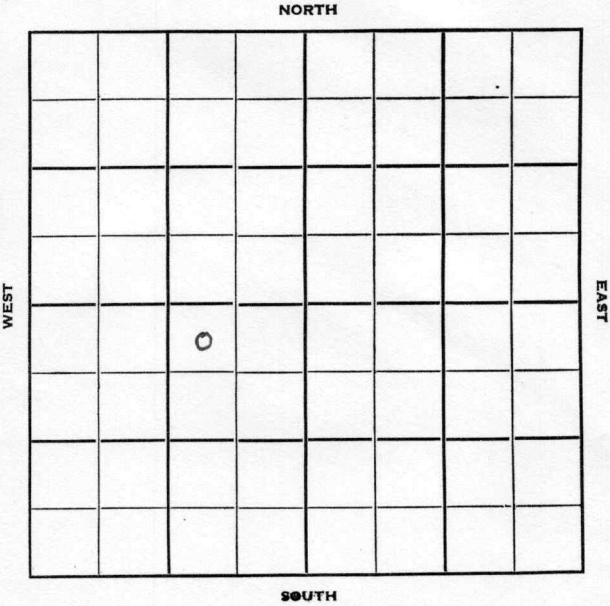

Butler

KANSAS 5E

Sec. 6 Twp. 24 R. 5E

Well No. #2 Claassen Farm

Morrison Drlg. Company

Contractor


330' Ft. from N. Line

 Ft. from S. Line

990' Ft. from E. Line

 Ft. from W. Line

NW NE SW

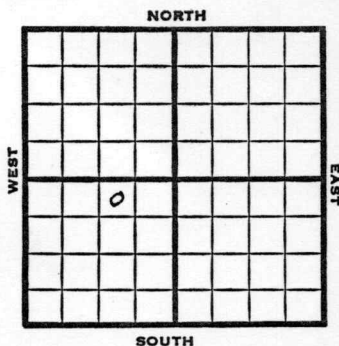

1951 Elev. 1467' REPORT

3/14 RUR

4/11 Spud 3-13-51
D&A TD 2500

8" @ 135

Miss 2451

5" @ 2451 TD 2491

S/8 bo 50 bw DD 2500

12 bo 60 bw SP 2466

15 qt/2466 water

D&A

ABANDONED

County Butler State KansasSec. 6 (Blk.
Twp.) 24 (Sur.
Rge.) 5E Map No.Operator Morrison Drlg.Well No. 2 Farm ClaassenElev. 1467 Location NW NE SW330Ft. From N Line SW990Ft. From E Line Quarter1st. ReportCompletion APR 11 1951RemarksSpudding Date 3-13-51Drlg. Data D & A TD 25008" @ 135 Miss. 2451 5" @ 2451 TD 2491S/ 8 bo 50 bw DD 2500 12 bo 60 bwSP 2466 15 qt/ 2466 waterD & A

J. E. TYRA