
FORM 51 25M 8-50 WESTERN Butler KANSAS

Section 6 Township 24 Range 5E

Well No. #3 Classen (Claassen)

Company Morrison Drlg.

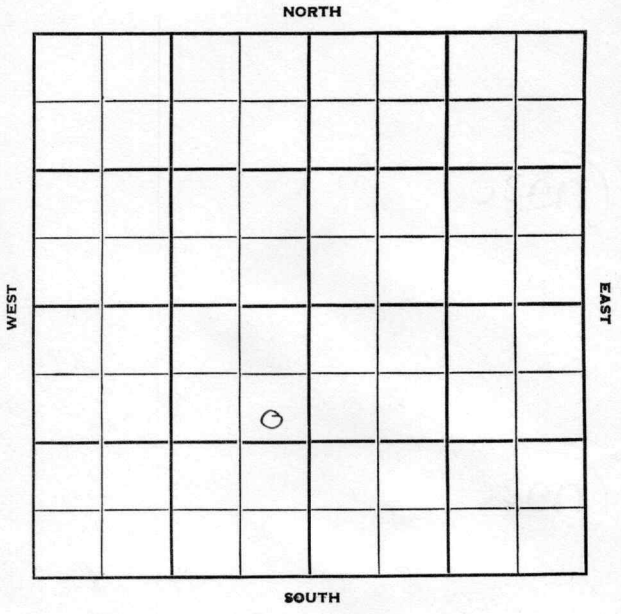

FORM 252-B
10M 10-50 PETROL

Butler

KANSAS

Sec. 6 Twp. 24 R. 5E

Well No. #3 Classen Farm

Morrison Drlg. Company

Contractor


990' Ft. from N. Line

Ft. from S. Line

330' Ft. from E. Line

Ft. from W. Line

SE NE SW

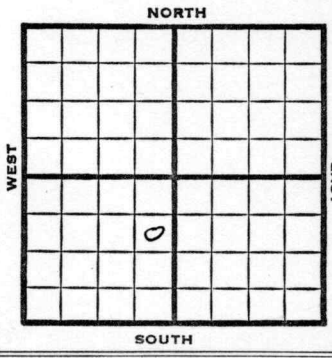

1952	Elv. 1469' REPORT
1/23	Drlg.
2/6	"
2/13	Cong. 2439 Miss 2465 TD 2469 7" @ 2467'
2/27	Oil well TD 2480' Cong. 2439' Miss 2465' TD 2469' 7" @ 2467' DD 2480' PB 2478' Comp. 35 BOPD COMPLETED

FORM 275 FOR SALE BY KANSAS BLUE PRINT CO.

County Butler State Kansas

Sec. 6 (Blk. Twp.) 24 (Sur. Rge.) 5E Map No.

Operator Morrison Drlg.

Well No. 3 Farm Classen

Elev. 1469 Location SE NE SW



990 Ft. From N Line SW

330 Ft. From E Line Quarter

1st. Report JAN 23 1952

Completion

Remarks

Spudding Date

Drlg. Data

Drlg.

J. E. TYRA

FORM 275 FOR SALE BY KANSAS BLUE PRINT CO.


County Butler State Kansas

Sec. 6 (Blk. Twp.) 24 (Sur. Rge.) 5E Map No.

Operator Morrison Drlg.

Well No. 3 Farm Classen

Elev. 1469 Location SE NE SW

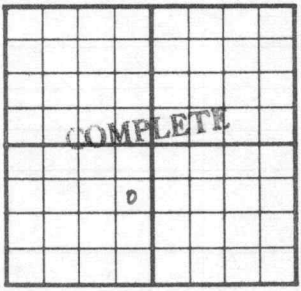

990 Ft. From N Line SW

330 Ft. From E Line Quarter

1st. Report

Completion FEB 27 1952

Remarks

Spudding Date

Drlg. Data Oil well TD 2480

Cong. 2439 Miss. 2465 TD 2469

7" @ 2467 DD 2480 PB 2478

Comp. 35 bopd

J. G. McGEHEE