


Section 6 Township 24 Range 5EWell No. #6 Classen (*Claassen*)Company Rex & Morris

NORTH

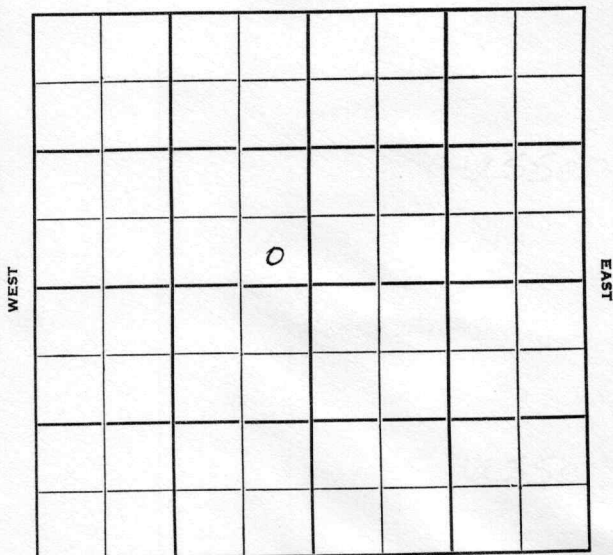

SOUTH

Butler

KANSAS

Sec. 6 Twp. 24 R. 5 E

Well No. # 6 Claassen Farm

Rex & Morris Company

Contractor

Hazlett Pool


Ft. from N. Line

330 Ft. from S. Line

330 Ft. from E. Line

Ft. from W. Line

SESE NW

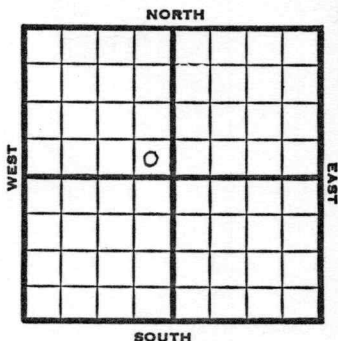

1951

Elev. 1471'

REPORT


6/6

Location

6/27

Oil well TD 2497'
KC 2084' Cong 2453' Miss 2473'
7" @ 2475 TD 2497' Hydrofrac
Comp. 40 BOPD

COMPLETED

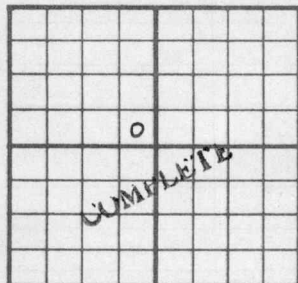County Butler State KansasSec. 6 (^{Blk.}
(Twp.) 24 (^{Sur.}
(Rge.) 5E Map No.Operator Rex & MorrisWell No. 6 Farm ClaassenElev. 1471 Location SE SE NW330 Ft. From S Line NW330 Ft. From E Line Quarter

1st. Report

Completion JUN 27 1951Remarks Hazlett Pool

Spudding Date

Drlg. Data Oil well TD 2497KC 2084 Cong. 2453 Miss. 24737" @ 2475 TD 2497 HydrofracComp. 40 bopd

J. E. TYRA