Range: 19 W
Township: 2 S
Section: 36

Phillips County
Friebus Farm No. 1
Carter Oil Co. Company

Sec.

o			

Twp.

6	5	4	3	2	1
7	8	9	10	11	12
18	17	16	15	14	13
19	20	21	22	23	24
30	29	28	27	26	25
31	32	33	34	35	36

Cnl SW NW

Elev. _____ T.D. 3861½

Date Drilled 6/14/41

Correlation by _____

Prod. Pott. 328 B.

Discovery well

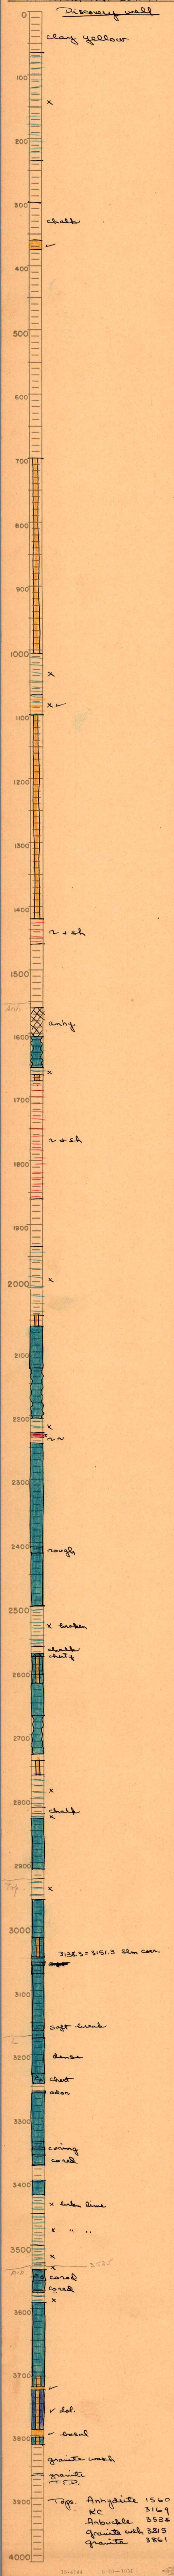

Tops. Anhydrite 1560
KC 3169
Arbuckle 3535
granite wash 3815
granite 3861