

Butler

Form 51-5M-9-28-27423

Map No. Sec. 29 Twp. 24^S R. 4^E

Well No. Patrover Farm

City of Patrover Company

NORTH

WEST

EAST

SOUTH

Location.....

Rig Up.....

Drilling Remarks

Drilling Remarks

RECORD

Cased..... in..... ft.

Sand.....

Gas.....

Oil.....

Total Depth.....

PRODUCTION

1st 24 hrs. Nat.....

1st 24 hrs. after shot.....

Gas..... cu. ft.....

Dry Hole.....

Abandoned.....

Map No. Sec. Twp. R.

Well No. Farm


..... Company

..... Ft. from N. Line

..... Ft. from S. Line

..... Ft. from E. Line

..... Ft. from W. Line

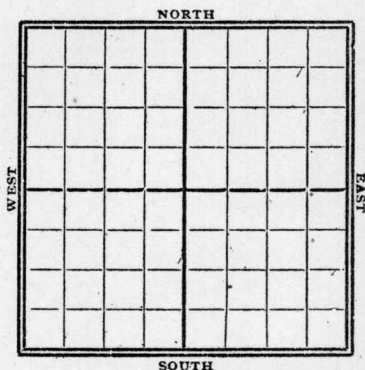

Date

REPORT

Gypsy Records

11/5

Abd T.D. 1600'

Butler
 K14 KANSAS SEC. *29* TWP. *24/S* R. *4E*
 MAP NO. _____
 WELL NO. *Patwin*
City of Patwin COMPANY _____

CONTRACTOR _____

SECTION PLAT

ABANDONED

0			

_____ FT. FROM N. LINE
 _____ FT. FROM S. LINE
 _____ FT. FROM E. LINE
 _____ FT. FROM W. LINE

no record

RECORD

LOCATION _____

CASED _____ IN. _____ FT.

RIG UP _____

SAND _____

DRILLING AND REMARKS:

GAS _____

OIL _____

TOTAL DEPTH *1600*

PRODUCTION

1ST 24 HRS. NAT. _____

1ST 24 HRS. AFTER SHOT _____

GAS _____ Cu. Ft.

DRY HOLE ☒

ABANDONED ☒

DATE

Nov 5 19*18* _____ SCOUT