KANSAS

FORM 51 5M 10-41 PETROL


Butler

Section 31 Township 24 Range 4-E

Well No. #3 Maxwell

Company Bennett Abel

Miscellaneous

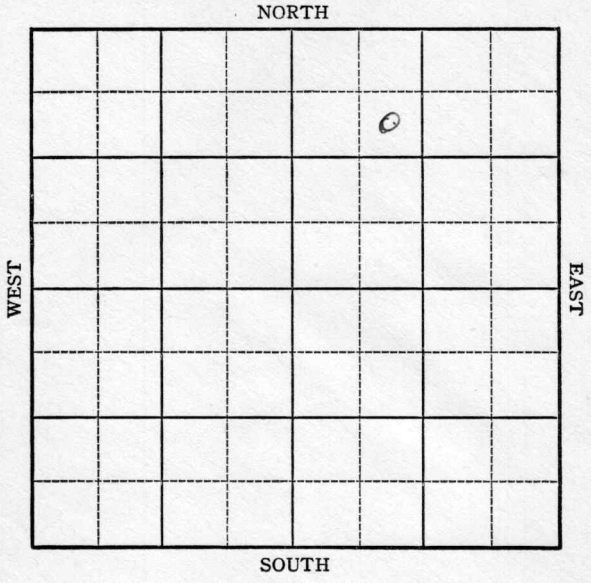

Form 252-A
5M 5-42 Petrol

KANSAS Butler

Sec. 31 Twp. 24 R. 4-E

Well No. #3 Maxwell Farm

Bennett Abel Company


(Miscellaneous)

990 Ft. from N. Line

Ft. from S. Line

Ft. from E. Line

990 Ft. from W. Line

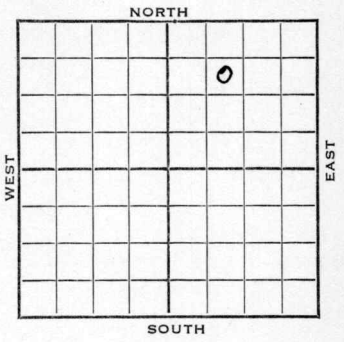

1942	REPORT
9/2	Machine.
9/9	345 SD
9/16	15" @ 37', 12" @ 129' Drlg 1205
9/23	10" @ 1269, 8" @ 1880 12" @ 2000
9/30	TD 2000 - SD repairs
10/7	K.C. 2198 6" - 2370 Miss 2655 5" - 2657 TD RUST
10/14	Miss. 2655 5" - 2657 Water T.D. 2726'

ABANDONED

Form 26 200 Bks 5-42 Petrol Butler KANSAS

Map No. 14 Sec. 31 Twp. 24 R. 4E

Well No. 3 Maxwell

Bennett Abel Company

FIRST REPORT Contractor

SE NW NE


990 Ft. from N. Line

Ft. from S. Line

Ft. from E. Line

990 Ft. from W. Line

SECTION PLAT

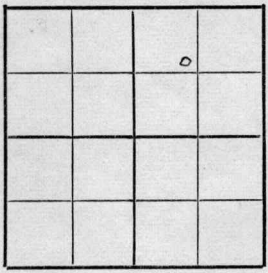

MISCELLANEOUS

Location

Rig up

Drilling and Remarks:

Machine

RECORD

Cased in., ft.

Sand

Gas

Oil

Total Depth

PRODUCTION

1st 24 hrs. Nat.

1st 24 hrs. after shot

Gas Cu. Ft.

Dry Hole

Abandoned

Date

SEP 2 1942 19 S. J. LEWIS Scout

Form 26 200 Bks 5-42 Petrol Butler KANSAS

Map No. 14 Sec. 31 Twp. 24 R. 4E

Well No. 3 Maxwell

Bennett Abel Company

ABANDONED Contractor

SE NW NE

990 Ft. from N. Line


Ft. from S. Line

Ft. from E. Line

990 Ft. from W. Line

MISCELLANEOUS

SECTION PLAT

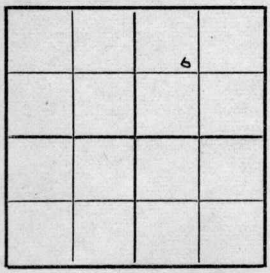

Location

Rig up

Drilling and Remarks:

Wis 2655
5" @ 2657
Water.

RECORD

Cased in., ft.

Sand

Gas

Oil

Total Depth 2726

PRODUCTION

1st 24 hrs. Nat.

1st 24 hrs. after shot

Gas Cu. Ft.

Dry Hole

Abandoned

Date

OCT 14 1942 19 S. J. LEWIS Scout