


Section 31 Township 24 Range 4-E

Well No. ~~#8 McGill~~ #10 Maxwell

Company Maxwell Petroleum

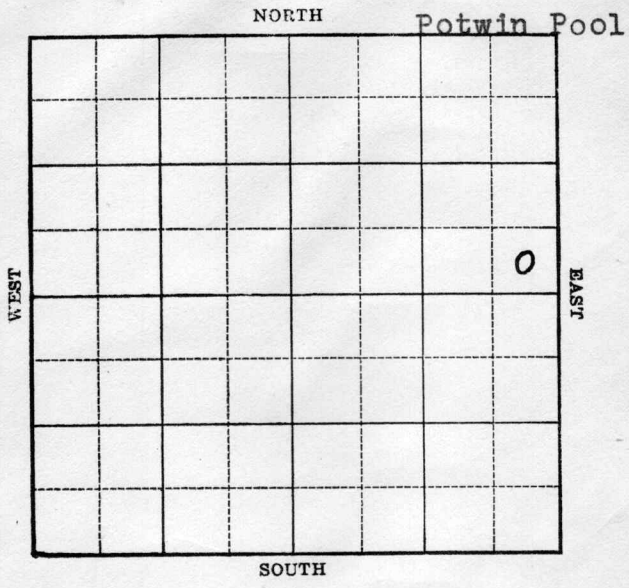

KANSAS

Butler

Sec. 31 Twp. 24 R. 4-E

Well No. ~~#8 McGill~~ #10 Maxwell Farm

Maxwell Petr. _____ Company

(Potwin)


Ft. from N. Line

330 Ft. from S. Line

330 Ft. from E. Line

Ft. from W. Line

Elev. 1338

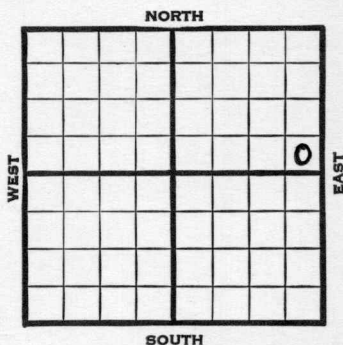[illegible]

Butler

KANSAS

Map No. 14 Sec. 31 Twp. 24 R. 4EWell No. 8 McGillMaxwell Petroleum

Company

Contractor

FIRST REPORT

SE NE

 Ft. from N. Line330 Ft. from S. Line330 Ft. from E. Line Ft. from W. Line

SECTION PLAT

			o

POTWIN POOL

Location Rig up

Drilling and Remarks:

Mach.

RECORD

Cased in., ft.Sand Gas Oil Total Depth

PRODUCTION

1st 24 hrs. Nat. 1st 24 hrs. after shot Gas Cu. Ft.Dry Hole Abandoned

Date

JUN 28 1939

19

S. J. LEWIS

Scout

Butler

KANSAS

Map No. 14 Sec. 31 Twp. 24 R. 4EWell No. 10 Maxwell
Maxwell Petroleum CompanyCORRECTION

Contractor

SE NE

_____ Ft. from N. Line

330 Ft. from S. Line330 Ft. from E. Line

_____ Ft. from W. Line

SECTION PLAT

POTWIN POOL

Location _____

Rig up _____

Drilling and Remarks:

Reported:

8 McGill

RECORD

Cased _____ in., _____ ft.

Sand _____

Gas _____

Oil _____

Total Depth _____

PRODUCTION

1st 24 hrs. Nat. _____

1st 24 hrs. after shot _____

Gas _____ Cu. Ft.

Dry Hole _____

Abandoned _____

Date

JUL 5 1939

19

S. J. LEWIS

Scout

Butler

KANSAS

Map No. 14 Sec. 31 Twp. 24 R. 4EWell No. 10 MaxwellMaxwell Petroleum

Company

Contractor

COMPLETED

SE NE

 Ft. from N. Line330 Ft. from S. Line330 Ft. from E. Line Ft. from W. Line

SECTION PLAT

POTWIN POOL

Location Rig up

Drilling and Remarks:

*Miss 2676**7" @ 2676**2000 acid**Pump 106*

RECORD

Cased in., ft.Sand Gas Oil Total Depth 2691

PRODUCTION

1st 24 hrs. Nat. 1st 24 hrs. after shot Gas Cu. Ft.Dry Hole Abandoned

Date

AUG 2 1939

19

S. J. LEWIS Scout