
Butler

KANSAS

SECTION 24 TOWNSHIP 27S RANGE 4E

WELL NO. #1 Smith

COMPANY F.L. Skaer

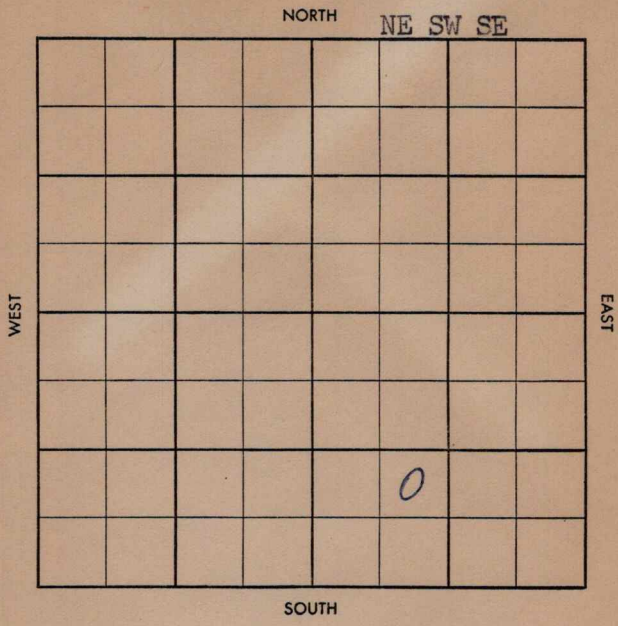

FORM 504-3 SUNRAY

39

S-513-B

County Butler Elev.

Sec. 24 Twp. 27 Rge. 4E

Company F. L. Skaer

Farm Name Smith No. 1

TOPS	DEPTH	LOG	DATUM
Anh.			
Tp.			
H.			
Tr.			
Dg.			
B. L.			
L.			
K.C.			
B.K.C.			
Ce.			
C.			
M.			
M.			
K.			
Mz.			
Mq.			
V.			
S.			
S.			
A.			
R.			
Pf.			
G.			
T.D.			

Loc. in Sec. NE SW SE

Geol.

Contr. White & Ellis

Pool Augusta



Date Comm. MIRT

Co. Lse. No. Sec. T. R.

S-513-B

County Butler Elev. 1225RB

Sec. 24 Twp. 27 Rge. 4E

Company F. L. Skaer

Farm Name Smith No. 1

TOPS	DEPTH	LOG	DATUM
Anh.			
Tp.			
H.			
Tr.			
Dg.			
B.L.			
L.	1757		
K.C.	2134		
B.K.C.	2338		
Ce.			
C.			
M.	2747		
M.			
K.			
Mz.			
Mq.			
V.			
S.			
S.			
A.			
R.			
Pf.			
G.			
T.D.	2900		

Loc. in Sec. NE SW SE

Geol.

Contr. White & Ellis

Pool Augusta

ABANDONED

FEB 5 '58

Date Comm. 1-30-58 8" 203/150

MIRT FEB 5 '58 no log on DST

D & A

Co. Lse. No. Sec. T. R.