

Map No. _____ Sec. 24 Twp. 27 R. 4
Well No. 1 Weidlein Farm
Weidlein Etal Company

N

 ΔA

四

S

Location -----

Drilling Remarks:

Rig Up -----

Drilling Remarks:

RECORD

Cased ----- in.-----ft.

Sand -----

Gas _____

Oil _____

Total Depth_____

PRODUCTION

1st 24 hrs. Nat.-----

1st 24 hrs. after shot-----

Gas ----- cu. ft.

Dry Hole -----

Abandoned -----

Map No. _____ Sec. 24 Twp. 27 R. 4

Well No. 1. Weidlein Farm


Weidlein et al Company

920 Ft. from N. Line

_____ Ft. from S. Line

920 Ft. from E. Line

_____ Ft. from W. Line

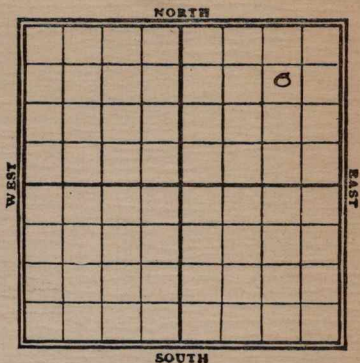

Date	REPORT
1950	<u>Spudding</u>
17	<u>DR 530'</u>
23	<u>Shut Down 600'</u>
29	<u>1414' - 1480' -</u>
	<u>420,000 cu ft Gas</u>

COMPLETED

"PORT
First Report"

Map No. K 11 Sec. 24 Twp. 27 R. 4Well No. 1 Heidlein
Heidlein et al Company

Contractor

SECTION PLAT

920 Ft. from N. Line

Ft. from S. Line

920 Ft. from E. Line

Ft. from W. Line

			①

FIRST REPORT

Location

Rig up

Drilling and Remarks:

Spud

RECORD

Cased _____ in., _____ ft.

Sand _____

Gas _____

Oil _____

Total Depth _____

PRODUCTION

1st 24 hrs. Nat. _____

1st 24 hrs. after shot _____

Gas _____ Cu. Ft.

Dry Hole _____

Abandoned _____

Date

1/2 1919

Pyle

Scout

Map No. K11 Sec. 24 Twp. 27 R. 4Well No. 1 WeidleinWeidlein et al Company

Contractor

SECTION PLAT

920 Ft. from N. Line

Ft. from S. Line

920 Ft. from E. Line

Ft. from W. Line

Location

Rig up

Drilling and Remarks:

RECORD

Cased _____ in., _____ ft.

Sand 1414 - 1480

Gas _____

Oil _____

Total Depth _____

PRODUCTION

1st 24 hrs. Nat. _____

1st 24 hrs. after shot _____

Gas 420,000 Cu. Ft.

Dry Hole _____

Abandoned _____

Date

1/29 1920

Pyle

Scout