


Map No. **KANSAS** Sec. **25** Twp. **24** R. **3E**
 Well No. **1- Joseph** Farm
Cornick Oil Company

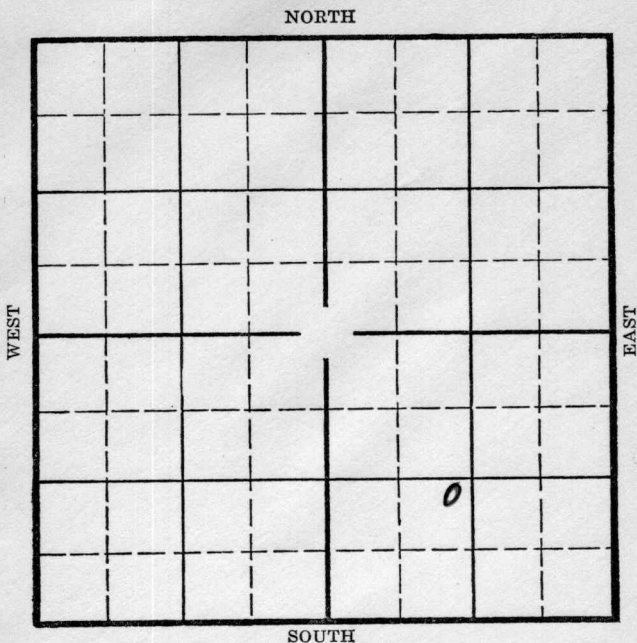

Location _____
 Drilling Remarks _____

Rig Up _____
 Drilling Remarks _____

RECORD

Cased _____ in. _____ ft.
 Sand _____
 Gas _____
 Oil _____
 Total Depth _____

PRODUCTION

1st 24 hrs. Nat. _____
 1st 24 hrs. after shot _____
 Gas _____ cu. ft. _____
 Dry Hole _____
 Abandoned _____

Butler


Map No. 25 Sec. 24 Twp. 3E

Well No. 1-Joseph Farm

Cosmic Oil

Company

NORTH

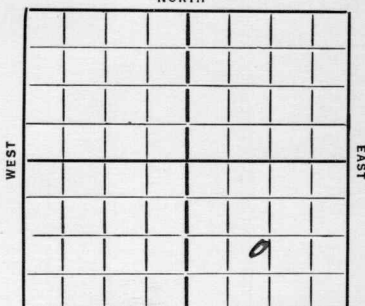

Ft. from N. Line

1240 Ft. from S. Line

Ft. from E. Line

1240 Ft. from W. Line

Elevation 1326

SOUTH

Date

REPORT

1935
11/27 Rgn Mch.
12/6 440 15" 225
12/13 " 900
12/19 " 1375
12/26 " 1430 10" 1234
1/2/36 " 2095 8" 2086
1/10 " 2719
1/17 Top Miss 2702 TD 2720
3 barrels Oil & 24 Wtr P/day
3000 acid
1/22 Miss 2702
TD 2740 - 3000 acid
PB 2720 More acid
6 gal Oil
Lots of water

COMPLETED

KANSAS

Map No. 13 Sec. 25 Twp. 24 R. 3EWell No. 1- Joseph
Cosmic oil Company

Contractor

FIRST REPORTS

SECTION PLAT

Ft. from N. Line

1240 Ft. from S. Line

Ft. from E. Line

1240 Ft. from W. Line

Location.....

Rig up.....

Drilling and Remarks:

Sign machine

RECORD

Cased.....in., ...ft.

Sand.....

Gas.....

Oil.....

Total Depth.....

PRODUCTION

1st 24 hrs. Nat.....

1st 24 hrs. after shot.....

Gas.....Cu. Ft.

Dry Hole.....

Abandoned.....

Date

11-27-35 192.....

ORVAL MANNSCHRECK

Scout

Map No. 13 Sec. 25 Twp. 24 R. 3 E

Well No. 1- Joseph

Cosmic Oil Company

Contractor

SECTION PLAT

Ft. from N. Line

1240 Ft. from S. Line

Ft. from E. Line

1240 Ft. from W. Line

		0	

COMPLETED

Location

Rig up

Drilling and Remarks:

3000 acid
P.B. 2720

more acid

60 oil

lots of water

RECORD

Cased _____ in., _____ ft.

Sand MISS 2702

Gas _____

Oil _____

Total Depth 2740

PRODUCTION

1st 24 hrs. Nat. _____

1st 24 hrs. after shot _____

Gas _____ Cu. Ft.

Dry Hole _____

Abandoned _____

Date

JAN 22 1936

192 _____ Scout

ORVAL MANN SCHRECK