


Section 25 Township 24 Range 3E

Well No. #6 Joseph

Company J. H. Waggnor

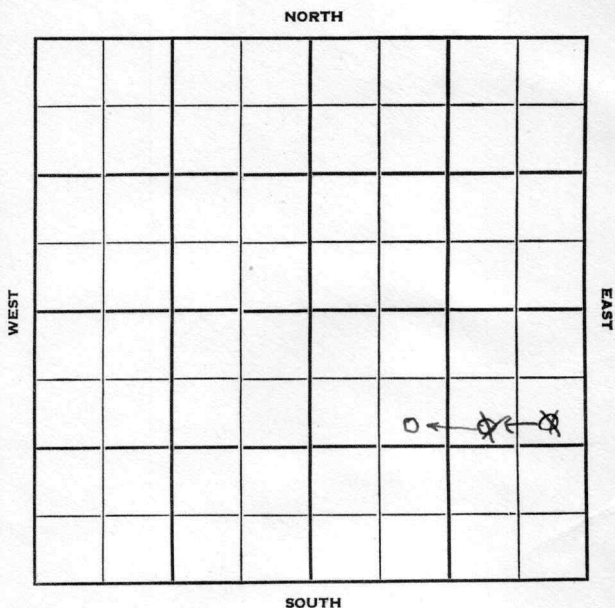

Butler

KANSAS

Sec. 25 Twp. 24 R. 3E

Well No. #6 Joseph Farm

J. H. Waggoner Company

Contractor

Pottwin Pool

1090' Ft. from N. Line


Ft. from S. Line

330' Ft. from E. Line

990 Ft. from W. Line

~~SE NW SE~~

~~SE NE SE~~ (Twin Well)

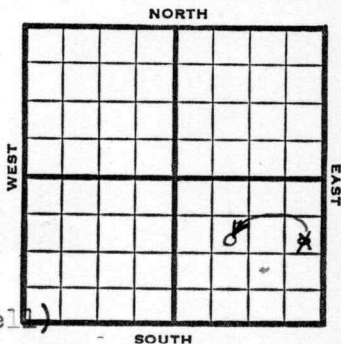

1951

Elev. 1315' REPORT

9/12 RUR

10/31

Spud 9-12-51

Oil Well TD 2727

12" @ 147 8" @ 1899

Miss 2699-2711 4" @ 2699

TD 2727 500 A

Comp. 30 bopd 10% wtr.

COMPLETED

J. E. TYRA

Kansas

Map No. _____ Sec. 25 Twp. 24 R. 3EWell No. 6 JosephJ. H. Waggner Company**CORRECTION**

Contractor

SE NW SE

SECTION PLAT

		0	

1090 Ft. from N. Line

_____ Ft. from S. Line

_____ Ft. from E. Line

990 Ft. from W. LineButler County

Location _____

Rig up _____

Drilling and Remarks:

Reported 32

SE NE SE

RECORD

Cased _____ in., _____ ft.

Sand _____

Gas _____

Oil _____

Total Depth _____

PRODUCTION

1st 24 hrs. Nat. _____

1st 24 hrs. after shot _____

Gas _____ Cu. Ft.

Dry Hole _____

Abandoned _____


Date

SEP 19 1951

19

J. E. TYRA Scout

County Butler State Kansas
 Sec. 25 (Blk. 24) (Sur. 3E) Map No.
 Operator J. H. Waggnor
 Well No. 6 Farm Joseph
 Elev. 1315 Location SE NW SE (twin well)

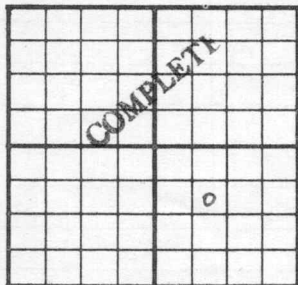

1090 Ft. From N Line SE
990 Ft. From W Line Quarter

1st. Report

Completion OCT 31 1951

Remarks Potwin Pool

Spudding Date 9-12-51

Drlg. Data Oil well TD 2727

12" @ 147 8" @ 1899 Miss. 2699-2711

4" @ 2699 TD 2727 500 A

Comp. 30 bopd 10% water

J. E. TYRA