FORM 51 25M 3-49 PETROL


Butler

KANSAS

Section 25 Township 24 Range 3E

Well No. #1 Wilkinson

Company J. H. Wagner

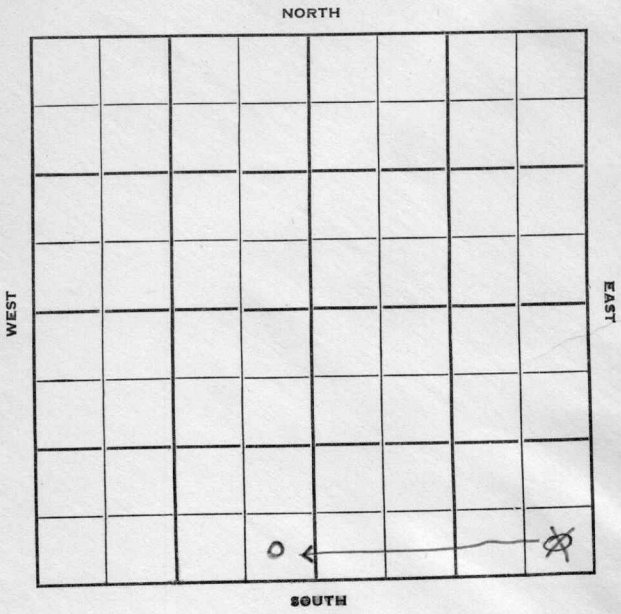

FORM 252-B
10M 9-49 PETROL

KANSAS

Butler


Sec. 25 Twp. 24 R. 3-E

Well No. #1 Wilkinson Farm

J H Wagner Company

Contractor

Miscellaneous

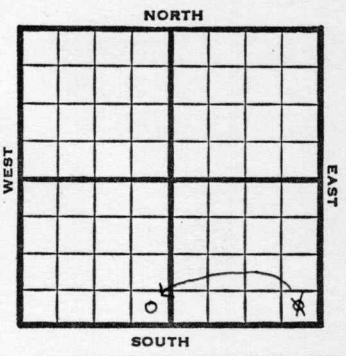

_____ Ft. from N. Line

330 Ft. from S. Line

330 Ft. from E. Line

_____ Ft. from W. Line

SE SE ~~SE~~ S W

1950	Elev 1332	REPORT
9/13	Spud 9-10-50 Drlg 300	
10/18	12" @ 1251 Miss 2708 SO 2724-25 250 A 5" @ 2719 TD 2725 Comp 20 bopd Completed	

COMPLETED

FORM 275 FOR SALE BY KANSAS BLUE PRINT CO.


County Butler State Kansas

Sec. 25 (Blk. Twp.) 24 (Sur. Rge.) 3E Map No.

Operator J. H. Wagner

Well No. 1 Farm Wilkinson

Elev. Location SE SE SE

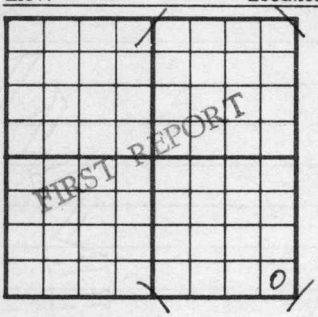

330 Ft. From S Line SE

330 Ft. From E Line Quarter

1st. Report SEP 13 1950

Completion

Remarks

Spudding Date 9-10-50

Drlg. Data Miscellaneous

drlg. 300

J. E. TYRA

Form 26 200 Bks. 11-49 Petrol

Kansas

Map No. _____ Sec. 25 Twp. 24 R. 3E

Well No. 1 Wilkinson


J. H. Wagner Company

CORRECTION

Contractor

SE SE SW

SECTION PLAT

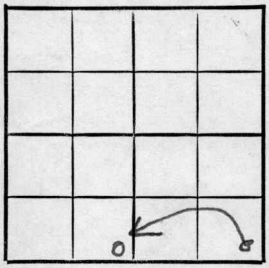

_____ Ft. from N. Line

330 Ft. from S. Line

330 Ft. from E. Line

_____ Ft. from W. Line

Butler County

Location _____

Rig up _____

Drilling and Remarks:

Reported
SE SE SE

RECORD

Cased _____ in., _____ ft.

Sand _____

Gas _____

Oil _____

Total Depth _____

PRODUCTION

1st 24 hrs. Nat. _____

1st 24 hrs. after shot _____

Gas _____ Cu. Ft.

Dry Hole _____

Abandoned _____

Date

SEP 27 1950 19

J. E. TYRA Scout

FORM 275 FOR SALE BY KANSAS BLUE PRINT CO.


County Butler State Kansas

Sec. 25 (Blk. Twp.) 24 (Sur. Rge.) 3E Map No.

Operator J. H. Wagner

Well No. 1 Farm Wilkinson

Elev. 1332 Location SE SE SW

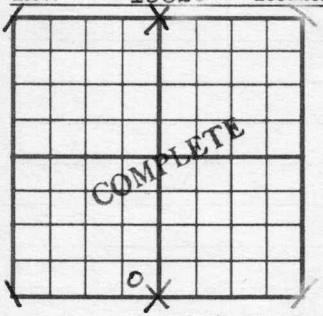

330 Ft. From S Line SW

330 Ft. From E Line Quarter

1st. Report

Completion OCT 18 1950

Remarks

Spudding Date 9-10-50

Drlg. Data Oil well TD 2725

12" @ 1251 Miss. 2708 SO 2724-25 250A

5" @ 2719 TD 2725 Comp. 20 bopd

J. E. TYRA