

Well No. 15 Wilkinson Farm

Company

NORTH


Ft. from N. Line

300 Ft. from S. Line

300 Ft. from E. Line

Ft. from W. Line

1930

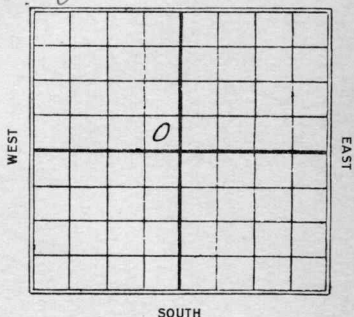

Date _____

REPORT

2/5

Ries

2/11

Plg. 700

2/9

" 1435

2/26

11 2000

$$\frac{3}{5}$$

6" 2698' Sand 2744-

45- Good show

3/2

S. D. 2768'

3/9

3/26

Show oil 2744-45

T.D. 2768

Try & Abandon

Butler

Map No. KANSAS Sec. 75 Twp. 74 R. 3^EWell No. 1 WilkinsonRoy Ramsey Company

Contractor

FIRST REPORTS

Ft. from N. Line

300 Ft. from S. Line300 Ft. from E. Line

Ft. from W. Line

SECTION PLAT

Location

Rig up ☒

Drilling and Remarks:

RECORD

Cased.....in.,ft.

Sand.....

Gas.....

Oil.....

Total Depth.....

PRODUCTION

1st 24 hrs. Nat.....

1st 24 hrs. after shot.....

Gas.....Cu. Ft.

Dry Hole.....

Abandoned.....

Date

FEB 5 1930

CHAS. L. SHERWOOD

192

Scout

Butler

KANSAS
 Map No. _____ Sec. 25 Twp. 24 R. 3

Well No. 1 Wilkinson

Ray Ramsey Company

Contractor

COMPLETE

SECTION PLAT

_____ Ft. from N. Line

300 Ft. from S. Line

300 Ft. from E. Line

_____ Ft. from W. Line

ABANDONED

Location _____

Rig up _____

Drilling and Remarks: _____

Shaw Oil 2744-45

RECORD

Cased _____ in., _____ ft.

Sand _____

Gas _____

Oil _____

Total Depth 2768

PRODUCTION

1st 24 hrs. Nat. _____

1st 24 hrs. after shot _____

Gas _____ Cu. Ft.

Dry Hole ☒

Abandoned ☒

Date

MAR 26 1930

CHAS. L. SHERWOOD

192 _____ Scout