


Butler

Form 51-5M-11-31-Palace

Map No. **KANSAS** Sec. *26* Twp. *24* R. *3E*

Well No. *1 Opfer* Farm
Sanford et al Company

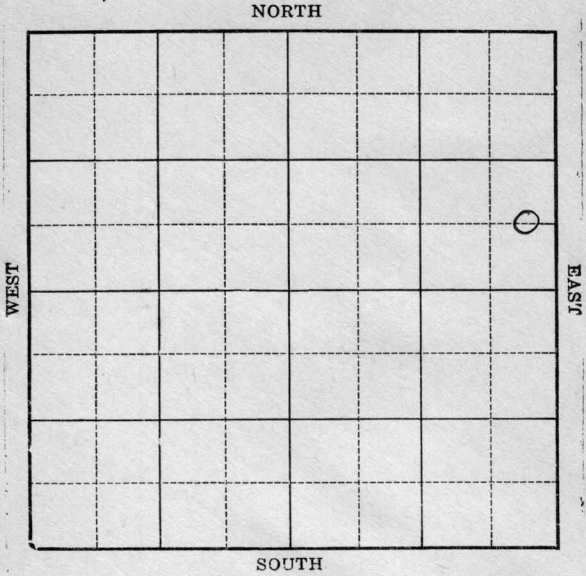

Location _____
Drilling Remarks _____

Rig Up _____
Drilling Remarks _____

RECORD

Cased _____ in. _____ ft.
Sand _____
Gas _____
Oil _____
Total Depth _____

PRODUCTION

1st 24 hrs. Nat. _____
1st 24 hrs. after shot _____
Gas _____ cu. ft.
Dry Hole _____
Abandoned _____

Butler

Map No. KANSAS Sec. 26 Twp. 24 R. 3 E


Well No. 1 Opfer Farm
Sanford et al Company

 Ft. from N. Line

660 Ft. from S. Line

300 Ft. from E. Line

 Ft. from W. Line

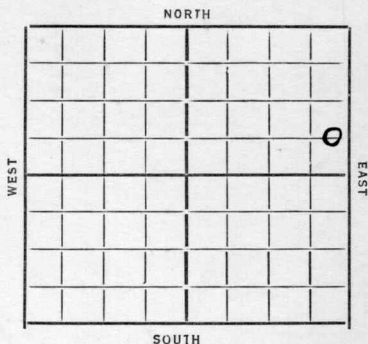

Date 7/9/34

REPORT

3/14 Rog.
3/22 BR
3/29 Rig
4/5 —
4/12 Dlg 250
4/19 12" 1135
4/26 Dlg 1875 10" 1635
5/3 " 2375 8" 2145
5/10 Line 2740 6" 2740
100' oil acidize
5/18 —
5/25 TD 2762 1800' fluid
5/31 No test
6/7 Est 30 Bbls.
6/14 —
6/20 Line 2740 TD 2762
1000 acid 12 oil & lots of water

COMPLETED

Map No. 13 Sec. 26 Twp. 24 R. 3E

Well No. 1- Oppw

Sanford et al Company

Contractor

FIRST REPORTS

SECTION PLAT

Ft. from N. Line

660 Ft. from S. Line

300 Ft. from E. Line

Ft. from W. Line

			0

Location

Rig up

Drilling and Remarks:

Rog

RECORD

Cased in., ft.

Sand

Gas

Oil

Total Depth

PRODUCTION

1st 24 hrs. Nat.

1st 24 hrs. after shot

Gas Cu. Ft.

Dry Hole

Abandoned

Date

3-14-34 192 O. Manschuet Scout

KANSAS

Map No. 13 Sec. 26 Twp. 24 R. 3 EWell No. 1- upperSanford et al Company

Contractor

COMPLETED

SECTION PLAT

			0

Ft. from N. Line

660 Ft. from S. Line300 Ft. from E. Line

Ft. from W. Line

Location _____

Rig up _____

Drilling and Remarks:

1000 acid12 oil andlots of water

RECORD

Cased _____ in., _____ ft.

Sand lime 2740

Gas _____

Oil _____

Total Depth 2762

PRODUCTION

1st 24 hrs. Nat. _____

1st 24 hrs. after shot _____

Gas _____ Cu. Ft.

Dry Hole _____

Abandoned _____

Date

6-20-37 19

ORVAL MANNSCHRECK

Scout