FORM 51


Butler

KANSAS

Section 34 Township 24 Range 3E

Well No. #6 Thierstein

Company Hammer & McLean

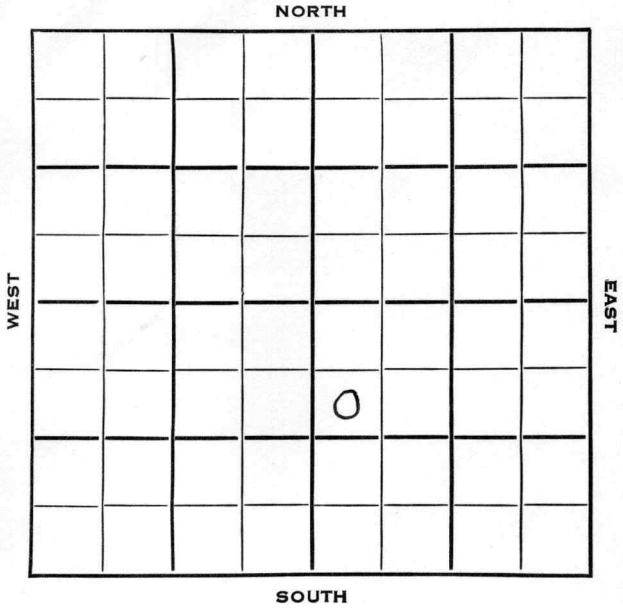

FORM 252-B

Butler KANSAS

Sec. 34 Twp. 24 R. 3 E

Well No. # 6 Theirstein Farm

Hammer & McLean Company

Contractor

Potwin Pool


990 Ft. from N. Line

Ft. from S. Line

Ft. from E. Line

330 Ft. from W. Line

SW NW SE

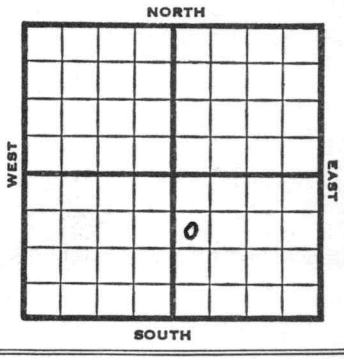

1953	Elev. 1352' REPORT
8/19	Spud 8-15-53 8" @ 90 Drlg. 1010'
9/9	Spud 8-15-53 8" @ 90 Miss 2740 TD 2760 D & A ABANDONED

FORM 275 FOR SALE BY KANSAS BLUE PRINT CO.


County Butler State Kansas

Sec. 34 (Blk. Twp.) 24 (Sur. Rge.) 3E Map No.

Operator Hammer & McLean

Well No. 6 Farm Theirstein

Elev. Location SW NW SE

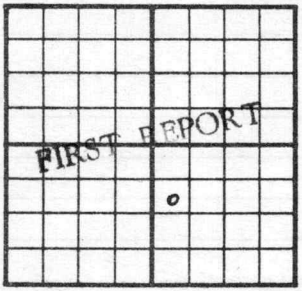

990 Ft. From N Line SE

330 Ft. From W Line Quarter

1st. Report AUG 19 1953

Completion

Remarks

Spudding Date 8-15-53

Drlg. Data Potwin Pool

8" @ 90 drlg. 1010

J. G. McGEHEE

FORM 275 FOR SALE BY KANSAS BLUE PRINT CO.


County Butler State Kansas

Sec. 34 (Blk. Twp.) 24 (Sur. Rge.) 3E Map No.

Operator Hammer & McLean

Well No. 6 Farm Theirstein

Elev. 1352 Location SW NW SE

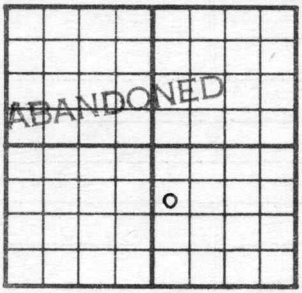

990 Ft. From N Line SE

330 Ft. From W Line Quarter

1st. Report

Completion SEP 9 1953

Remarks Potwin Pool

Spudding Date 8-15-53

Drlg. Data

8" @ 90 Miss. 2740 TD 2760

D & A

J. G. McGEE