
FORM 51 25M 8-50 WESTERN

Butler KANSAS

Section 34 Township 24 Range 3E

Well No. #1 Thurston (Thierstein)

Company H & M Drlg.

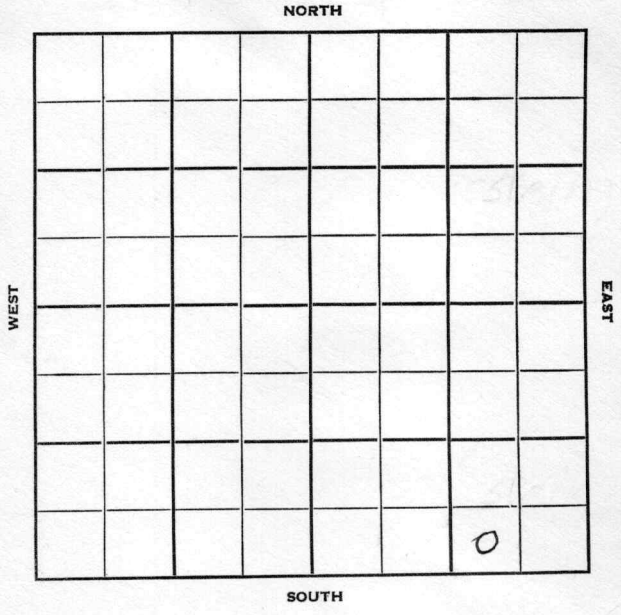

FORM 252-B
10M 11-50 PETROL

Butler

KANSAS

Sec. 34 Twp. 24 R. 3 E

Well No. # 1 Thurston Farm

H & M Drlg. Company

H & M Drlg. Contractor

Potwin Pool


_____ Ft. from N. Line

330 Ft. from S. Line

990 Ft. from E. Line

_____ Ft. from W. Line

SW SE SE

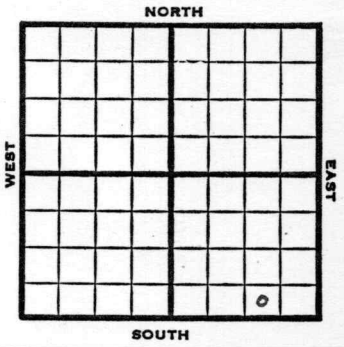

1951	Elev. 1357' REPORT
2/21	Location
6/27	Spud 5-31-51 Oil well TD 2738' 8" @ 65 Lans. 1998' KC 2385' Miss 2716' TD 2737' 5" @ 2733 DD 2738' 2000 A Comp. 25 BOPD

COMPLETED

FORM 275 FOR SALE BY KANSAS BLUE PRINT CO.


County Butler State Kansas

Sec. 34 (Blk. Twp.) 24 (Sur. Rge.) 3E Map No.

Operator H & M Drlg.

Well No. 1 Farm Thurston

Elev. Location SW SE SE

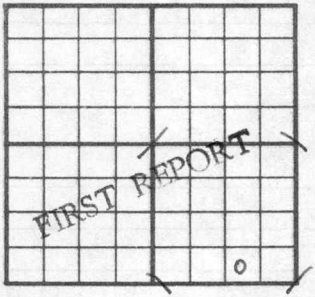

330 Ft. From S Line SE

990 Ft. From E Line Quarter

1st. Report FEB 21 1951

Completion

Remarks

H & M Drlg. - Contr.

Spudding Date

Drlg. Data

Location

J. E. TYRA

FORM 275 FOR SALE BY KANSAS BLUE PRINT CO.


County Butler State Kansas

Sec. 34 (Blk. Twp.) 24 (Sur. Rge.) 3E Map No.

Operator H & M Drlg.

Well No. 1 Farm Thurston

Elev. 1357 Location SW SE SE

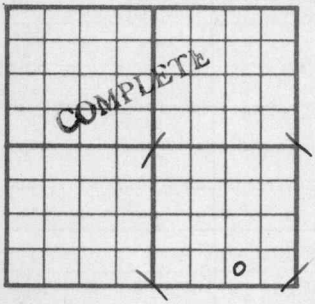

330 Ft. From S Line SE

990 Ft. From E Line Quarter

1st. Report

Completion JUN 27 1951

Remarks Potwin Pool

H & M Drlg. - Contr.

Spudding Date 5-31-51

Drlg. Data Oil well TD 2738

8" @ 65 Lans. 1998 KC 2385

Miss. 2716 TD 2737 5" @ 2733 DD 2738

2000 A Comp. 25 bopd

J. E. TYRA