

Section 34 Township 24 Range 3 EWell No. # 1 WiebeCompany H & M Drlg.

NORTH

WEST

EAST

SOUTH

Butler

KANSAS

Sec. 34 Twp. 24 R. 3E

Well No. #1 Wiebe Farm

H & M Drlg. Company

H & M Drlg. - Contr. Contractor


 Ft. from N. Line

330' Ft. from S. Line

330' Ft. from E. Line

 Ft. from W. Line

SE SE SW

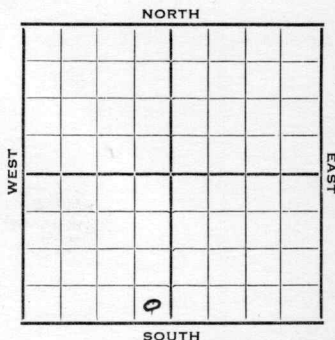

1952 Elev. 1368' REPORT

4/9 MI
5/7 Spud 4-8-52
Oil Well TD 2764'
8" @ 100
Miss chat 2755 TD 2763
5" @ 3758' DD 3764' 5 bailers
oil 1000 A Comp. 25 bopd 75 bw
75 bw

COMPLETED

County **Butler** State **Kansas**

Sec. **34** (Blk.) **24** (Sur.) **38** Map No.

Operator H & M Drlg.

Well No. **1** Farm **Wiebe**

Elev.	Location	SE	SE	SW
-------	----------	----	----	----

330 Ft. From S Line SW

330 Ft. From E Line Quarter

1st. Report APR 9 1952

Completion

Remarks

H & M Drlg. - Contr.

Spudding Date

Drlg. Data

MI

J. G. McGEHEE

Well No. **1** Farm **Wiebe**

Elev.	1368	Location	SE SE SW
-------	------	----------	----------

330 Ft. From S Line SW

330 Ft. From E Line Quarter

1st. Report

Completion MAY 7 1952

Remarks

H & M Drlg. - Contr.

Spudding Date **4-8-52**

Drlg. Data Oil well TD 2764

8" @ 100 Miss. chat 2755 TD 2763

5" @ 3758 DD 3764 5 bailers oil 1000 A

Comp. 25 bopd 75 bw

J. G. McGEHEE