


Map No. Rom Sec. 35 Twp. 24 R. 3
Well No. 1 Brainerd Farm
Vickers Ref. + Sanford Company

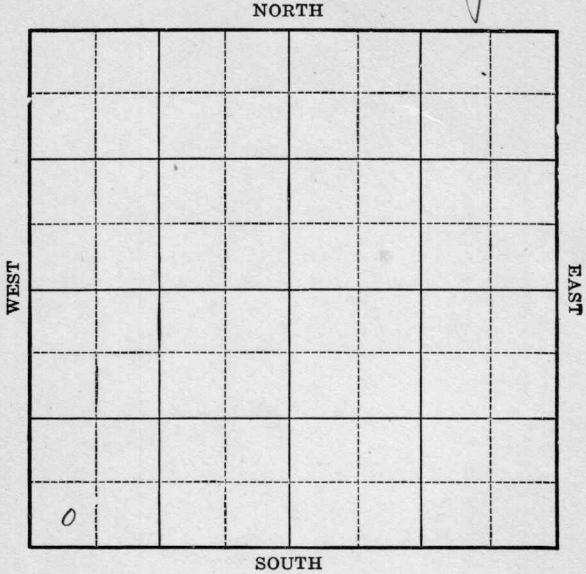

Location _____
Drilling Remarks _____

RECORD

Cased _____ in. _____ ft.
Sand _____
Gas _____
Oil _____
Total Depth _____

Rig Up _____
Drilling Remarks _____

PRODUCTION

1st 24 hrs. Nat. _____
1st. 24 hrs. after shot _____
Gas _____ cu. ft.
Dry Hole _____
Abandoned _____

Map No. 1 Kansas Sec. 35 Twp. 24 R 3Well No. 1 Brammer FarmVickers Pet + Sanford Company

NORTH

Ft. from N. Line

200 Ft. from S. Line

Ft. from E. Line

200 Ft. from W. Line

WEST

EAST

SOUTH

Brammer

Date

REPORT

1/253/24 Location6/2 —————7/5 ~~ROG~~ —————7/22 Spud7/29 ~~Log 900'~~8/7 ~~—————~~7/29 Abandoned Location

Map No. 13 KANSAS Sec. 35 Twp. 24 R. 3

Well No. 1 Brainerd

Vickers Pet & Sanford Company

Contractor

FIRST REPORT

SECTION PLAT

-----Ft. from N. Line

200 Ft. from S. Line

-----Ft. from E. Line

200 Ft. from W. Line

Location LV

Rig Up 7/29/25

Drilling and Remarks:

Abandoned
this loc
new location

250 S. L.
748 W. L.

RECORD

Cased ----- in., ----- ft.

Sand -----

Gas -----

Oil -----

Total Depth -----

PRODUCTION

1st 24 hrs. Nat. -----

1st 24 hrs. after shot. -----

Gas ----- Cu. Ft.

Dry Hole. -----

Abandoned -----

Date

on other well in envelope

250 S. L.
748 W. L.
M. A. BENEAR

3/24 1925

Scout