
Form 51-5M-12-36 Com'l KANSAS Butler

Section 35 Township 24 Range 3-E

Well Number 3 Brainard "B"

Company Sacco Oil

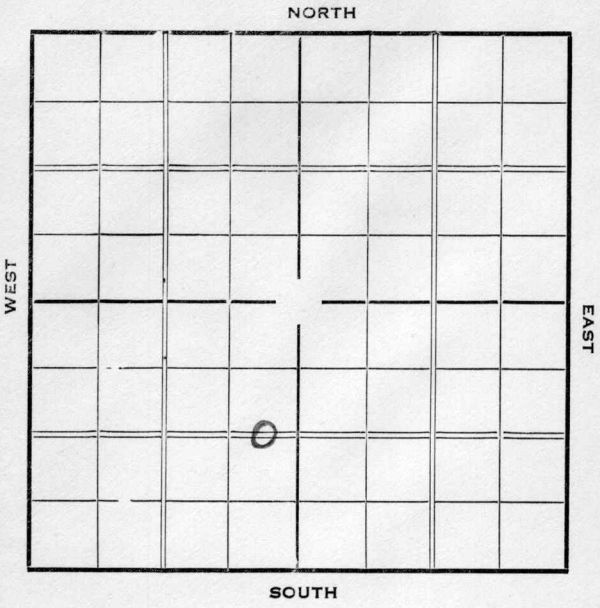

Form 252-A—5M—2-37—Palace KANSAS Butler

Sec. 35 Twp. 24 R. 3-E

Well No. #3 Brainard "B" Farm


Sacco Oil Company

1320 Ft. from N. Line

Ft. from S. Line

330 Ft. from E. Line

Ft. from W. Line

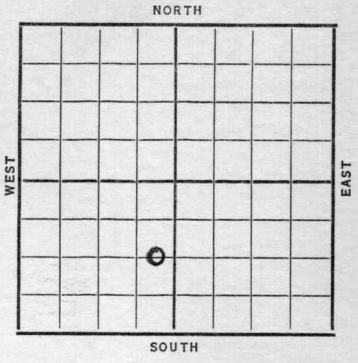

Date	REPORT
1937	
3/31	Drlg. 500'.
4/8	Drlg. 1365', 12" @ 1135'
4/16	10" @ 1641'. Drlg. 1785'.
4/23	Drlg. 2040'.
4/30	8" @ 2158'. Drlg. 2726'.
5/5	Miss. 2736'.
	T.D. 2801'.
	ABANDONED ~~COMPLETED~~ ABANDONED

Form 26—1M Bks.—2-29 KANSAS Butler


Map No. 13 Sec. 35 Twp. 24 R. 3E

Well No. 3 Brainard "B"

Sacco Oil Company

Contractor

SECTION PLAT

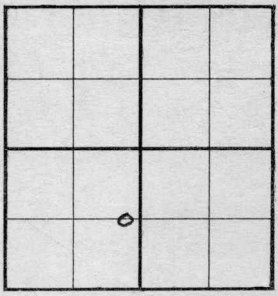

1320 Ft. from N. Line

_____ Ft. from S. Line

330 Ft. from E. Line

_____ Ft. from W. Line

FIRST REPORT

Location _____

Rig up _____

Drilling and Remarks:

Drlg 500.

RECORD

Cased _____ in., _____ ft.

Sand _____

Gas _____

Oil _____

Total Depth _____

PRODUCTION

1st 24 hrs. Nat. _____

1st 24 hrs. after shot _____

Gas _____ Cu. Ft.

Dry Hole _____

Abandoned _____

Date

MAR 31 1937 19____

S. J. LEWIS Scout

Form 26—1M Bks.—2-29 Butler KANSAS

Map No. 13 Sec. 35 Twp. 24 R. 3 E

Well No. 3 - Brainard "B"

Sacco Company

Contractor

ABANDONED


1320 Ft. from N. Line

Ft. from S. Line

330 Ft. from E. Line

Ft. from W. Line

SECTION PLAT

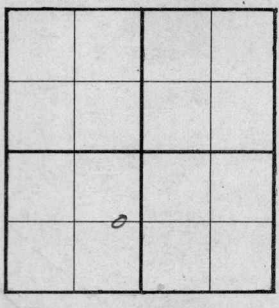

Location

Rig up

Drilling and Remarks:

NO Shows

D & A

RECORD

Cased in., ft.

~~Sand~~ MISS - 2736

Gas

Oil

Total Depth 2801

PRODUCTION

1st 24 hrs. Nat.

1st 24 hrs. after shot

Gas Cu. Ft.

Dry Hole

Abandoned

Date

MAY 5 - 1937 19

H D Hatfield Scout