
Harvey

DX 78-1

Section 22 Township 24 Range 2E

Well No. #1 Nickel

Company Shawver-Armour

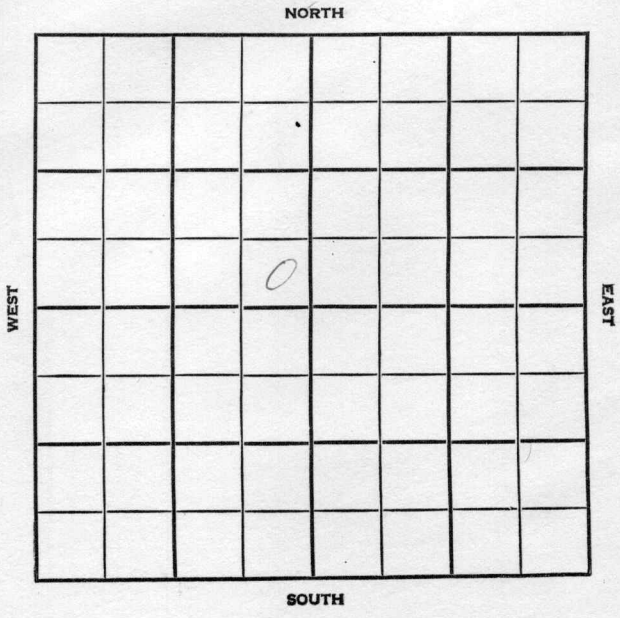

Harvey KANSAS

SEC.	TWP.	R.
22	24	2E

WELL NO.

#1 Nickel FARM

COMPANY

Shawver-Armour

CONTRACTOR

Co.Tools

WILDCAT


_____ FT. FROM N. LINE

_____ FT. FROM S. LINE

_____ FT. FROM E. LINE

_____ FT. FROM W. LINE

SE SE NW

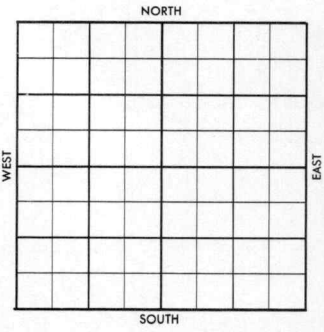

1956	ELEVATION 1402' REPORT
5-23	Comm. 5-21-56 Drlg. 280
6-6	8 5/8" @ 190 TD 3355 D & A H. 1903', L. 2174', KC 2415'. BKC 2601', Burg Sd. 3855', M.Chert 2895 K. 3186', A. 3277', Syl. 3335',S. 3348' TD 3355'.

ABANDONED

FORM 504-5 SUNRAY

FORM 513 SUNRAY

County Harvey Elev.

Sec. 22 Twp. 24 Rge. 2E

Company Shawver-Armour

Farm Name Nickel No. 1

TOPS	DEPTH	LOG	DATUM
Anh.			
Tp.			
H.			
Tr.			
Dg.			
Bl.			
L.			
K.C.			
B.K.C.			
Ce.			
C.			
M.			
M.			
K.			
Mz.			
Mo.			
V.			
S.			
S.			
A			
R.			
P€.			
G.			
T.D.			

Loc. in Sec. SE SE NW

Geol.

Contr. Co. tools

Pool Wildcat

FIRST REPORT

MAY 23 '56

Date Comm. 5-21-56

drlg. 280

Co. Lse. No. Sec. T. R.

FORM 513 SUNRAY

County Harvey Elev. 1402 Co.

Sec. 22 Twp. 24 Rge. 2E

Company Shawver-Armour

Farm Name Nickel No. 1

TOPS	DEPTH	LOG	DATUM
Anh.			
Tp.			
H.	1903		
Tr.			
Dg.			
Bl.			
L.	2174		
K.C.	2415		
B.K.C.	2601		
Ge. Burg sd	2855		
C.			
M. chert	2895		
M.			
K.	3186		
Mz.	3277		
Mo.	3338		
V.	3345		
S.	3368		
S.			
A			
R.			
P€.			
G.			
T.D.	3355		

Loc. in Sec. SE SE NW

Geol.

Contr. Co. tools

Lse.

Pool Wildcat



No.

Date Comm. 5-21-56 JUN 6 1956

Sec.

drlg. 280 MAY 29 '56 8 5/8 190 ✠ 3100

JUN 6 '56 TD 3355 D&A

T.

R.