


Butler

Form 51-5M-4-27-27423

Map No. KANSAS Sec. 36 Twp. 24<sup>S</sup> R. 3<sup>E</sup>

Well No. 8-Joseph Farm  
Peterson O & G. Company

NORTH

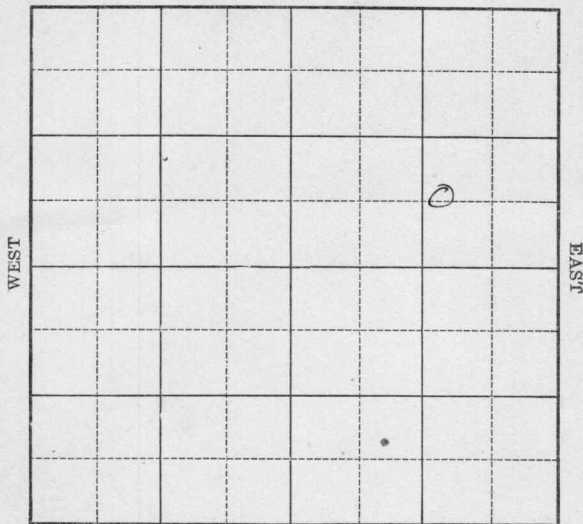

SOUTH

Location \_\_\_\_\_

Drilling Remarks \_\_\_\_\_

Rig Up \_\_\_\_\_

Drilling Remarks \_\_\_\_\_

RECORD

Cased \_\_\_\_\_ in. \_\_\_\_\_ ft.

Sand \_\_\_\_\_

Gas \_\_\_\_\_

Oil \_\_\_\_\_

Total Depth \_\_\_\_\_

PRODUCTION

1st 24 hrs. Nat. \_\_\_\_\_

1st 24 hrs. after shot \_\_\_\_\_

Gas \_\_\_\_\_ cu. ft.

Dry Hole \_\_\_\_\_

Abandoned \_\_\_\_\_

Map No. .... Sec. .... Twp. .... R. ....

Well No. .... Farm


..... Company

..... Ft. from N. Line

..... Ft. from S. Line

..... Ft. from E. Line

..... Ft. from W. Line

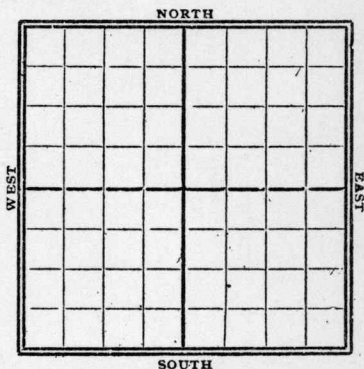

1923

Date

REPORT

*Gypsy Records*

5/16

*T.S. 2667-76'*

*small show*

*T.D. 2750'*

*Abandoned*

Butler

K13 KANSAS SEC. 36 TWP. 24S R. 3E

WELL NO. 8 Joseph

Petroleum 845.

COMPANY

CONTRACTOR

ABANDONED

## SECTION PLAT

|  |  |  |   |
|--|--|--|---|
|  |  |  |   |
|  |  |  | 0 |
|  |  |  |   |
|  |  |  |   |

Ft. FROM N. LINE

Ft. FROM S. LINE

Ft. FROM E. LINE

Ft. FROM W. LINE

no record

LOCATION

RIG UP

DRILLING AND REMARKS:

26 67 } top of  
 26 76 } sand  
 sand show

## RECORD

CASED IN. FT.

SAND

GAS

OIL

TOTAL DEPTH 2750

## PRODUCTION

1ST 24 HRS. NAT.

1ST 24 HRS. AFTER SHOT

GAS Cu. Ft.

DRY HOLE

ABANDONED

DATE

5/16

192

3

SCOUT