

Harvey

KANSAS


SECTION 23
~~24~~ TOWNSHIP 24S RANGE 2E

WELL NO. #1 Corfman "E"

COMPANY Petroleum Inc. NWSWSW

NORTH

~~SW SW NW~~

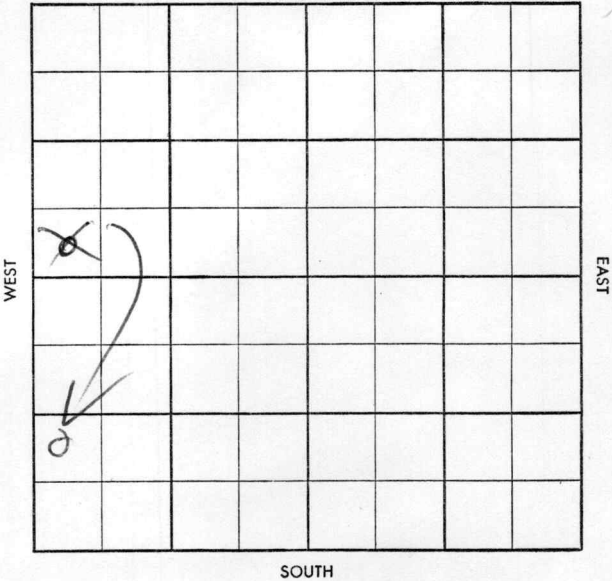

Twp. 10 Pool ✓
 Co. ✓ 10 ✓
 Co. ✓ 10 ✓

WILDCAT

S-513-B

County <u>Harvey</u> Elev. _____				Co.	
Sec. <u>24</u> Twp. <u>24</u> Rge. <u>2E</u>					
Company <u>Petroleum Inc.</u>					
Farm Name <u>Corfman "E"</u> No. <u>1</u>					
TOPS	DEPTH	LOG	DATUM	Loc. in Sec. _____	Lse.
Anh. _____				<u>SW SW NW</u>	
Tp. _____					
H. _____					
Tr. _____					
Dg. _____				Geol. _____	
B.L. _____				Contr. _____	
L. _____				<u>Garvey</u>	
K.C. _____				Pool _____	
B.K.C. _____				<u>Wildcat</u>	
Ce. _____					No.
C. _____					
M. _____					
M. _____					
K. _____					
Mz. _____					
Mq. _____					
V. _____					
S. _____					
S. _____					
A. _____				Sec.	
R. _____					
Pf. _____					
G. _____					
T.D. _____					
Date Comm. _____				T.	
<u>WORT 2950' ETD</u>					
				R.	

CORRECTION

Twp. 10 Pool 10Co. 10 Facet 10

S-513-B

County Harvey

Elev. _____

Sec. 23 81Twp. 24Rge. 25Company Petroleum Inc.Farm Name Cornman " "No. 1

TOPS	DEPTH	LOG	DATUM
Anh.			
Tp.			
H. <u>Stal</u>	<u>2085</u>		
Tr.			
Dg.			
B.L.			
L.	<u>2157</u>		
K.C.	<u>2370</u>		
B.K.C.	<u>2557</u>		
Ce. <u>Burg</u>	<u>2821</u>		
C. <u>po</u>	<u>2825</u>		
M. <u>do</u>	<u>2861</u>		
M.			
K.			
Mz.			
Mq.			
V.			
S.			
S.			
A.			
R.			
Pf.			
G.			
T.D.	<u>2940</u>		

Loc. in Sec. SW SW SWNW SW SW

Geol. _____

Contr. _____

Garvey

Pool _____

Wildcat

ABANDONED

SEP 3 '58

Date Comm. 8-15-58 8/20/90WORT 2950' STD AUG 20 '58 2105 AUG 27 '58DST 2822-26 45" 5 Mod - fairDST 2822-28 1hr 45' OCW 920' 1hr OCWFPO -520 BHP 920-20 TD 2910 D+D

SEP 3 '58

D&A