


KANSAS Butler

FORM 51 5M PETROL

Section 1 Township 24 Range 3E

Well No. 1 Joseph "C"

Company Vickers

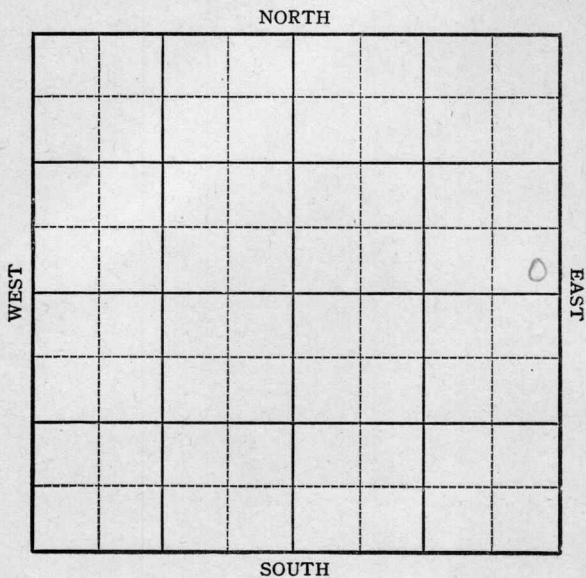

KANSAS

Butler County

Sec. 1 Twp. 24 R. 3E

Well No. 1 Joseph "C" Farm

Vickers Company


Miscellaneous

Ft. from N. Line

330 Ft. from S. Line

330 Ft. from E. Line

Ft. from W. Line

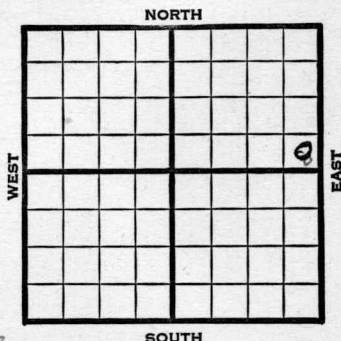

SE NE Elev. 1337

1945

REPORT

4/25 cable
5/3 Rig
5/10 "
5/17 "
5/24 Spud 40'
5/31 20" @ 40
15" @ 205
Drlg.
6/8 Drlg. 1010
6/27 Arb. 2748
TD 2753' HFW

ABANDONED


Kansas Pool Name MiscellaneousMap No. 13 Sec. 1 Twp. 24 R. 3EWell No. 1 Joseph "C"Vickers Company

FIRST REPORT

Contractor

SE NE

SECTION PLAT

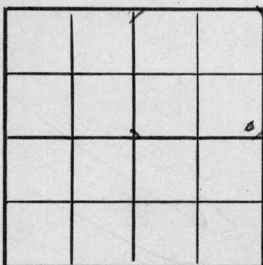 Ft. from N. Line330 Ft. from S. Line330 Ft. from E. Line Ft. from W. Line

Butler County

Location Rig up Drilling and Remarks:
cable

RECORD

Cased in., ft.Sand Gas Oil Total Depth

PRODUCTION

1st 24 hrs. Nat. 1st 24 hrs. after shot Gas Cu. Ft.Dry Hole Abandoned

Date

APR 25 1945


19

S. J. LEWIS

Scout

Kansas Pool Name MiscellaneousMap No. 13 Sec. 1 Twp. 24 R. 3EWell No. 1 Joseph "C"Vickers CompanyABANDONEDSE NE

Contractor

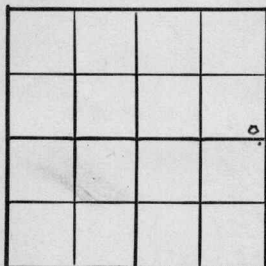E/133?
SECTION PLAT Ft. from N. Line330 Ft. from S. Line330 Ft. from E. Line Ft. from W. LineButler CountyLocation Rig up

Drilling and Remarks:

Per V2748HPW.

RECORD

Cased in., ft.Sand Gas Oil Total Depth 2753

PRODUCTION

1st 24 hrs. Nat. 1st 24 hrs. after shot Gas Cu. Ft.Dry Hole Abandoned

Date

JUN 27 1945 19S. J. LEWIS

Scout