

Butler

KANSAS

Section 26 Township 27 Range 4 EWell No. # 1 Stafford (*Stafford*)Company Butler County Drlg.

NORTH

						0	

WEST

EAST

SOUTH

Butler

KANSAS ✓

Sec. 26 Twp. 27 R. 4 E

Well No. # 1 Stafford Farm

Butler County Drlg. Company

Butler County Contractor


 Ft. from N. Line

330 Ft. from S. Line

990 Ft. from E. Line

 Ft. from W. Line

SW SE NE

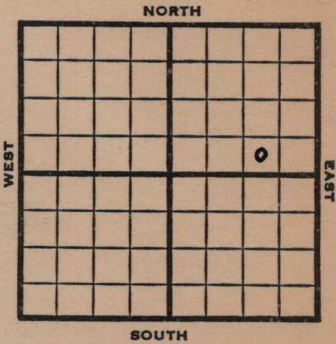

1953 **Elev. 1271'** REPORT

6/24 RUCT
7/29 Spud 6-19-53
D&A
TD 2710
13" @ 783
KC 2025,
8" @ 2350
Arb. 2642
5" @ 2660,
TD ~~XX~~ 2710 HFW
D&A

ABANDONED

County Butler State KansasSec. 26 (Blk. Twp.) 27 (Sur. Rge.) 4E Map No.Operator Butler County Drlg.Well No. 1 Farm StaffordElev. Location SW SE NE330 Ft. From S Line NE990 Ft. From E Line Quarter1st. Report JUN 24 1953

Completion

Remarks

Butler Co. - Contr.

Spudding Date

Drlg. Data

R U G T

County Butler State KansasSec. 26 (Blk.) 27 (Sur.) 4E Map No.Operator Butler County Drlg.Well No. 1 Farm StaffordElev. 1271 Location SW SE NE330 Ft. From S Line NE990 Ft. From E Line Quarter

1st. Report

Completion JUL 29 1953

Remarks

Butler Co - Contr.Spudding Date 6-19-53Drlg. Data D & A TD 271013" @ 783 KC 2025 8" @ 2350Arb. 2642 5" @ 2660 TD 2710 HFWD & A