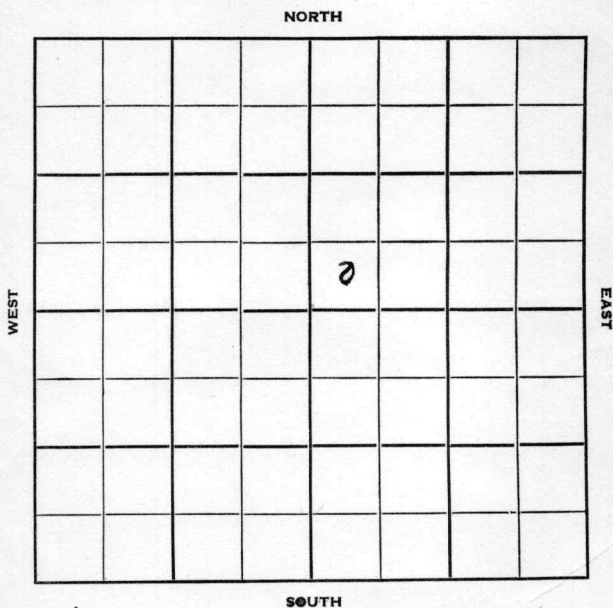


Section 7 Township 24 Range 3EWell No. #1 BarkerCompany D. T. Ingling

Butler KANSAS

Sec. 7 Twp. 24 R. 3 E

Well No. # 1 Barker Farm

D. T. Ingling Company

Contractor

Wildcat


 Ft. from N. Line

330 Ft. from S. Line

 Ft. from E. Line

330 Ft. from W. Line

SW SW NE

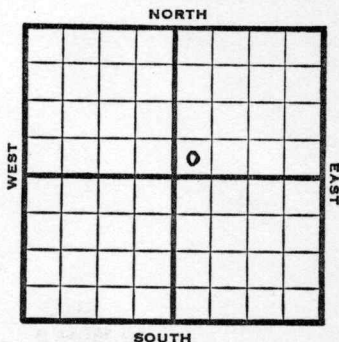

1952

Elev. 1385'

REPORT

1/2

Spud 12-23-51

8" @ 125'

Dr1g. 1370'

1/9

Spud 12-23-51

D&A TD 2800

8" @ 125

Lans. 2095

KC 2310

Miss 2764

TD 2800'

D&A


ABANDONED

County **Butler** State **Kansas**
Sec. **7** (**Blk.**) **24** (**Sur.**) **3E** Map No.
Operator **D. T. Ingling**
Well No. **1** Farm **Barker**
Elev. Location **SW SW NE**

330 Ft. From **S** Line **NE**
330 Ft. From **W** Line **Quarter**
1st. Report **JAN 2 1952**
Completion
Remarks
Spudding Date **12-23-51**

Drlg. Data

Wildcat**8" @ 125 drlg. 1370****J. E. TYRA**

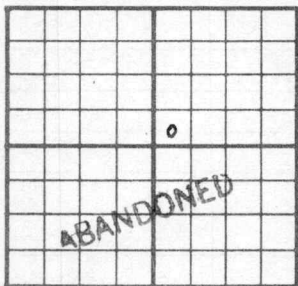County Butler State KansasSec. 7 (Blk.) 24 (Sur.) 3E Map No.Operator D. T. InglingWell No. 1 Farm BarkerElev. 1385 Location SW SW NE330 Ft. From S Line NE330 Ft. From W Line Quarter

1st. Report

Completion JAN 9 1952Remarks WildcatSpudding Date 12-23-51Drlg. Data D & A TD 28008" @ 125 Lans. 2095 KC 2310Miss. 2764 TD 2800D & A

J. E. TYRA