


Form 51--5M--11-31--Palace

Map No. KANSAS Sec. 11 Twp. 24 R. 22

Well No. 14 Acres Farm

~~Phillips Petroleum~~ Company

Walter NORTH Swann et al

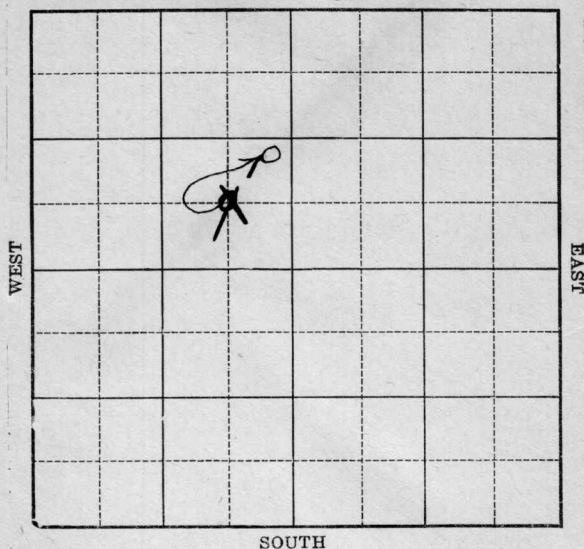

Location _____

Drilling Remarks

Rig Up

Drilling Remarks

RECORD

Cased _____ in. _____ ft.

Sand

Gas

Oil

Total Depth.....

PRODUCTION

1st 24 hrs. Nat.-----

1st 24 hrs. after shot_____

Gas _____ cu. ft.

Dry Hole

Abandoned

Rutler

Map No. KANSAS Sec. 11 Twp 24 R. 3E

Well No. 1 J. Harder Farm


~~Phillips Pet. & Service~~ Company
Walter Swain

1625 Ft. from N. Line

660 Ft. from S. Line

530
660 Ft. from E. Line

_____ Ft. from W. Line

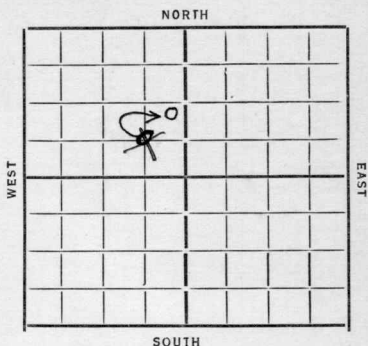

Date 1934

REPORT

6/6	Location
6/14	— 6/21 —
6/28	dyg 25
7/5	5D 250
7/12	CO 270
7/19	7 sq.
7/26	— 8/2 — 8/9 — 8/16 —
8/23	—
8/30	dyg 460 18" 345
9/6	—
9/13	— 9/20 — 9/27 —
10/4	1352 5D
10/11	— 10/18 — 10/25 — 11/1 —
11/8	— 11/15 — 11/22 — 11/28 —
12/6	— 12/13 —
12/21	10" 1348 C.O. 1352
12/27	dyg 1490
1/3/35	" 1520
1/10	" 1763
1/17	— 1/24 —
1/31	dyg 1820
2/7	" 1936

OVER

2/14 alg 2300 8" 1900
2/21 " 2472 6" 2400
2/27 Miss L. 2535
T 2554
D & A.

ABANDONED

KANSAS

Map No. 13 Sec. 11 Twp. 24 R. 32Well No. 1- J. HarderPhillips Pet. & Service Company

Contractor

FIRST REPORTS

SECTION PLAT

	0		

_____ Ft. from N. Line

660 Ft. from S. Line660 Ft. from E. Line

_____ Ft. from W. Line

Location ✓

Rig up _____

Drilling and Remarks:

RECORD

Cased _____ in., _____ ft.

Sand _____

Gas _____

Oil _____

Total Depth _____

PRODUCTION

1st 24 hrs. Nat. _____

1st 24 hrs. after shot _____

Gas _____ Cu. Ft.

Dry Hole _____

Abandoned _____

Date

6-6-34

19

ORVAL MANNSCHRECK

Scout

Map No. 13 Sec. 11 Twp. 24 R. 33

Well No. 1- J. Harder

Walter Swain et al Company

Contractor

CORRECTION

1625 Ft. from N. Line

_____ Ft. from S. Line

530 Ft. from E. Line

_____ Ft. from W. Line

SECTION PLAT

Location _____

Rig up _____

Drilling and Remarks:

*formerly reported
Phillips pit.
in c S E 2nd*

RECORD

Cased _____ in., _____ ft.

Sand _____

Gas _____

Oil _____

Total Depth _____

PRODUCTION

1st 24 hrs. Nat. _____

1st 24 hrs. after shot _____

Gas _____ Cu. Ft.

Dry Hole _____

Abandoned _____

Date

6-13-37 19

ORVAL MANNSCHRECK

Scout

KANSAS

Map No. 13 Sec. 11 Twp. 24 R. 3EWell No. 1- J. Harder
Walter Swain et al Company

Contractor

ABANDONED

SECTION PLAT

1625 Ft. from N. Line

Ft. from S. Line

530 Ft. from E. Line

Ft. from W. Line

	0		

Location

Rig up

Drilling and Remarks:

10 + 77

RECORD

Cased in, ft.

Sand Miss. 2535

Gas

Oil

Total Depth 2554

PRODUCTION

1st 24 hrs. Nat.

1st 24 hrs. after shot

Gas Cu. Ft.

Dry Hole

Abandoned

Date

2-27-35 192

ORVAL MANNSCHRECK

Scout