

WEST

EAST

SOUTH

Drilling Remarks

Drilling Remarks

RECORD

Cased_____in_____ft.

Sand

Gas _____

Oil _____

Total Depth.....

PRODUCTION

1st 24 hrs. Nat. _____

1st 24 hrs. after shot_____

Gas _____ cu. ft. _____

Dry Hole_____

Abandoned_____

KANSAS

Butler

Map No. _____ Sec. 36 Twp. 24 R. 3E

Well No. 2-B Mc Cramer Farm
Vickers Pet Company


_____ Ft. from N. Line

660 Ft. from S. Line

440 Ft. from E. Line

_____ Ft. from W. Line

NORTH

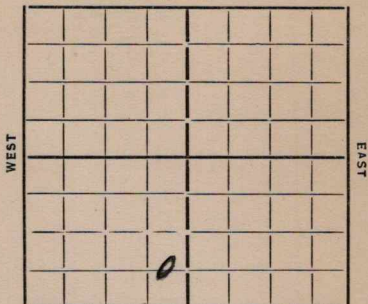

SOUTH

Elev. 1325

Date 9/35

REPORT

9/4 Rig
10/3 2128 Run 8"
10/19 Blg 2685
10/30 TML 2684
TD 2718
78 Blh.

COMPLETED

Butler
Map No. 13 Sec. 36 Twp. 24 R. 3EWell No. 2B-Mc Cramer
Vickers pet Company

Contractor

FIRST REPORTS

SECTION PLAT

	0		

Ft. from N. Line

660 Ft. from S. Line

440 Ft. from E. Line

Ft. from W. Line

Location

Rig up

Drilling and Remarks:

Rig

RECORD

Cased in., ft.

Sand

Gas

Oil

Total Depth

PRODUCTION

1st 24 hrs. Nat.

1st 24 hrs. after shot

Gas Cu. Ft.

Dry Hole

Abandoned

Date

9-4-35 192

ORVAL MANNSCHRECK

Scout

KANSASMap No. 18 Sec. 36 Twp. 24 R. 3EWell No. 213-McCramerVickers Petroleum Company

Contractor

COMPLETED

SECTION PLAT

	0		

Ft. from N. Line

660 Ft. from S. Line

440 Ft. from E. Line

Ft. from W. Line

Location

Rig up

Drilling and Remarks:

78 fms

RECORD

Cased in. ft.

Sand TML 2684

Gas

Oil

Total Depth 2718

PRODUCTION

1st 24 hrs. Nat.

1st 24 hrs. after shot

Gas Cu. Ft.

Dry Hole

Abandoned

Date

ORVAL MANNSCHRECK10-30-35 192

Scout