


Section 26 Township 27 Range 4^E

Well No. 10 Safford

Company Safford

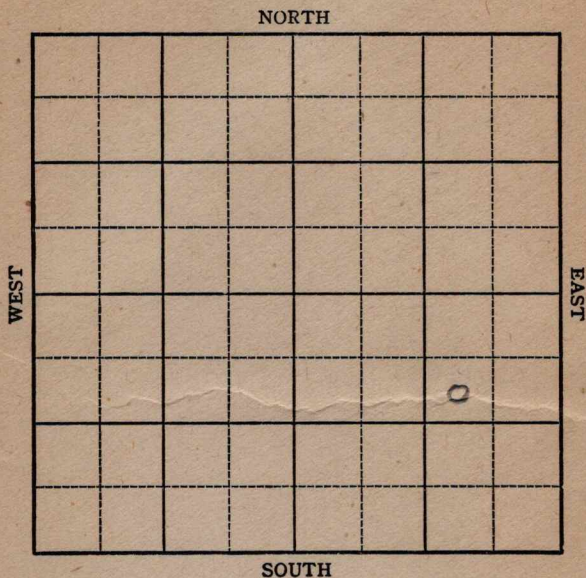

KANSAS

Butler

Sec. 26 Twp. 27 R. 4-E

Well No. #10 Safford Farm

Safford Company


Miscellaneous

990 Ft. from N. Line

 Ft. from S. Line

990 Ft. from E. Line

 Ft. from W. Line

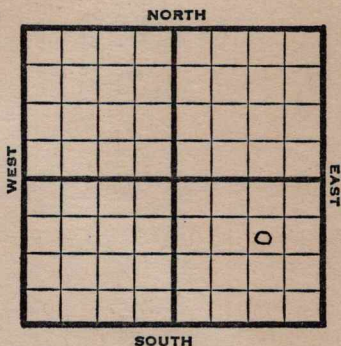

SW NE SE

1947

REPORT

5/14	10" @ 46' Drlg 675'
5/20	Drlg 1495'
5/27	6" @ 1590' Drlg 1955'
6/3	Lansing 1611 Kc 2009 TD 2083 SO
6/10	TD 2058' corrected 2500 acid.
6/18	KC 2009' 5" @ 2012' 2500 Acid Pump 15 Oil / 80W Pot 36.0 Gr. TD 2085'

COMPLETED

Map No. 15 11 Sec. 26 Twp. 27 R. 4E

Well No. 10 Safford

Safford

Company

FIRST REPORT

Contractor

SW NE SE

SECTION PLAT

990 Ft. from N. Line

Ft. from S. Line

990 Ft. from E. Line

Ft. from W. Line

Butler County

Location

Rig up

Drilling and Remarks:

10"@ 46'

675'

RECORD

Cased _____ in., _____ ft.

Sand _____

Gas _____

Oil _____

Total Depth _____

PRODUCTION

1st 24 hrs. Nat. _____

1st 24 hrs. after shot _____

Gas _____ Cu. Ft.

Dry Hole _____

Abandoned _____

Date

MAY 14 1947 19

S. J. LEWIS Scout

Map No. 11 Sec. 26 Twp. 27 R. 4E

Well No. 10 Safford

Safford Company

COMPLETE Contractor

SW NE SE

SECTION PLAT

			0

990 Ft. from N. Line

 Ft. from S. Line

990 Ft. from E. Line

 Ft. from W. Line

Butler County

Location

Rig up

Drilling and Remarks:

KC2009

5" C2012

2500 acid

Pump Oil 18W

82

86° Gr

RECORD

Cased in., ft.

Sand

Gas

Oil

Total Depth 2085

PRODUCTION

1st 24 hrs. Nat.

1st 24 hrs. after shot

Gas Cu. Ft.

Dry Hole

Abandoned

Date

JUN 1 8 1947 19 S. J. LEWIS Scout