


Map No. 15 Sec. 11 Twp. 24 R. 9
Well No. 6 Lewis Farm
Pelhamus et al Company

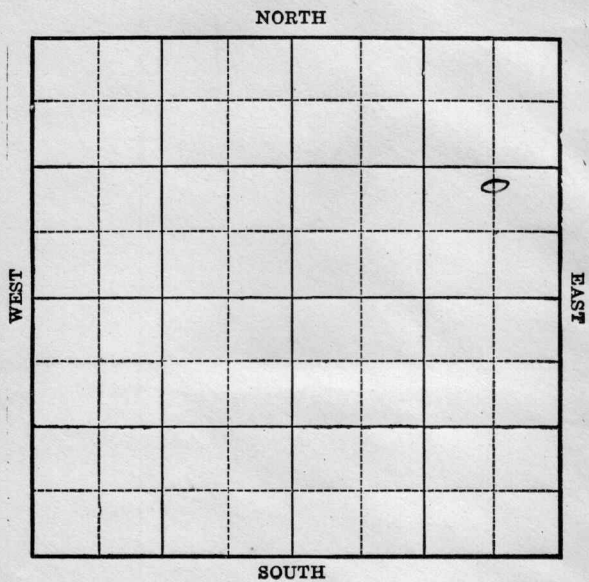

Location _____

Drilling Remarks:

RECORD

Cased _____ in. _____ ft.

Sand _____

Gas _____

Oil _____

Total Depth _____

Rig up _____

Drilling Remarks:

PRODUCTION

1st 24 hrs Nat. _____

1st 24 hrs. after shot _____

Gas _____ cu. ft.

Dry Hole _____


Abandoned _____

Map No. 75 Sec. 11 Twp. 24 R. 9Well No. 6 Lewis Farm
Palhamus Etal Company

Ft. from N. Line

11 W Ft. from S. Line660 Ft. from E. Line

Ft. from W. Line

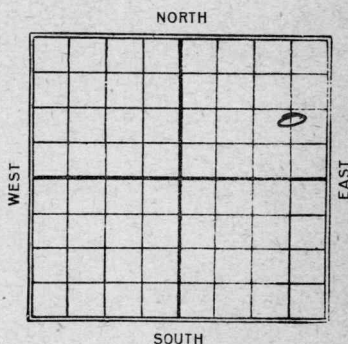

REPORT

Date

1924
5/22 Lumber
7/9 2262-2300
74.2315
110/150 Bbb

15 KANSAS
 Map No. _____ Sec. 11 Twp. 24 R. 9
 Well No. # 6 Lewis
 Palhamus et al Company
 Contractor

FIRST REPORT

SECTION PLAT

_____ Ft. from N. Line

1120 Ft. from S. Line

660 Ft. from E. Line

_____ Ft. from W. Line

			o

Location _____

Rig up _____

Drilling and Remarks:

timbers

RECORD

Cased _____ in., _____ ft.

Sand _____

Gas _____

Oil _____

Total Depth _____

PRODUCTION

1st 24 hrs. Nat. _____

1st 24 hrs. after shot _____

Gas _____ Cu. Ft.

Dry Hole _____

Abandoned _____

Date

M. A. BENEAR

MAY 22 1924

192

Scout

15 **KANSAS** Map No. _____ Sec. 11 Twp. 24 R. 9

Well No. 6 Lewis
Salhams et al Company

Contractor _____

SECTION PLAT

COMPLETED

			0

_____ Ft. from N. Line

1120 Ft. from S. Line

660 Ft. from E. Line

_____ Ft. from W. Line

Location _____

Rig up _____

Drilling and Remarks:

Sand 2262-2304

TD. 2315

110/150

RECORD

Cased _____ in., _____ ft.

Sand _____

Gas _____

Oil _____

Total Depth _____

PRODUCTION

1st 24 hrs. Nat. _____

1st 24 hrs. after shot _____

Gas _____ Cu. Ft.

Dry Hole _____

Abandoned _____

Date

JUL 9 1924

M. A. BENEAR

192_____

Scout