

DX 78-1


Butler

KANSAS

Section 8 Township 24 Range 5E

Well No. #1 Walters

Company J. H. Wagner

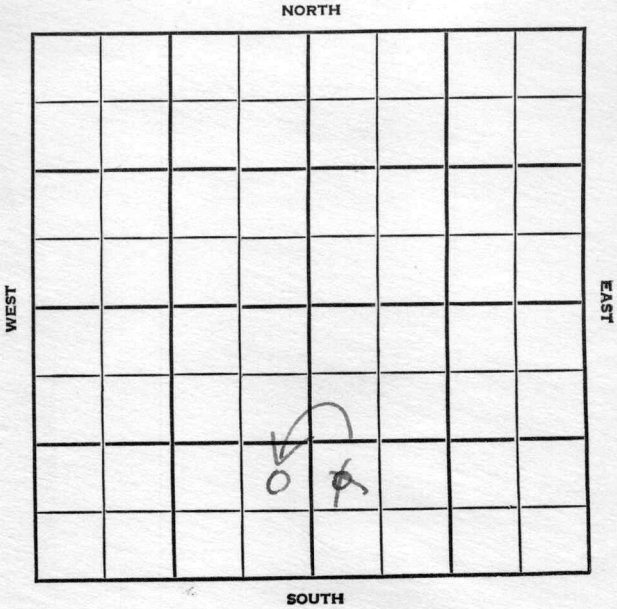

Butler

KANSAS

SEC.	8	TWP.	24	R.	5E
------	---	------	----	----	----

WELL NO.

1 Walters

FARM

COMPANY

J. H. Wagner

CONTRACTOR

Co. Tools

Windcat

Ft. from N. Line


Ft. from S. Line

Ft. from E. Line

Ft. from W. Line

NE SE SW

NW SW SE

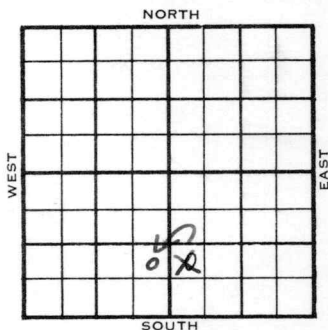

1955

ELEVATION

1169'

REPORT

6/22

RUCT

8/10

Comm 6-21-55

Base 1905

KC 2070

CE Burg 2450

V 2582

TD 2584

12 1/2" @ 1148 10" @ 1202 5 1/2" @

2440/40 TD 2584 PB 2448 vis frac 25 b

bopd SP 2180 15/2160-75 re perf

sd-oil-frac P/30 bopd sq perf 2160-75

CO to 2450 sd-oil-frac Comp 30 bopd

COMPLETED

County Butler Elev. _____
 Sec. 8 Twp. 24 Rge. 5E
 Company J. H. Wagner
 Farm Name Walters No. 1

TOPS	DEPTH	LOG	DATUM
Anh.			
Tp.			
H.			
Tr.			
Dg.			
Bl.			
L.			
K.C.			
B.K.C.			
Ce.			
C.			
M.			
M.			
K.			
Mz.			
Mq.			
V.			
S.			
S.			
A			
R.			
Pe.			
G.			
T.D.			

Loc. in Sec. _____
NW SW SE

Geol. _____
 Contr. _____
Co. tools

Pool _____
Wildcat

FIRST REPORT
 JUN 22 '55

Date Comm. _____

RUCT

Co.

Lse.

No.

Sec.

T.

R.

SCOUT TICKET

DX-201

Kansas

SEC.

8

TWP.

24

R.

5E

WELL NO.

#1 Walters

FARM

COMPANY

J. H. Wagner

CONTRACTOR

CORRECTION

NE SE SW


NORTH

____ FT. FROM N. LINE

990 FT. FROM S. LINE

330 FT. FORM E. LINE

____ FT. FROM W. LINE

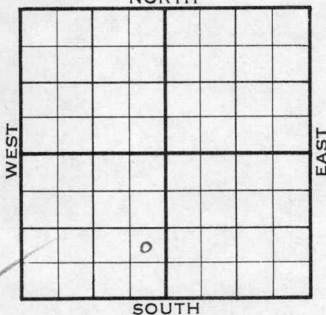

Butler County

☐

LOCATION

☐

RIG UP

DRILLING AND REMARKS:

Reported

NW SW SE

RECORD

CASED IN., FT.

SAND

GAS

OIL

TOTAL DEPTH

PRODUCTION

1ST 24 HRS. NAT.

1ST 24 HRS. AFTER SHOT

GAS CU. FT.

DRY HOLE

ABANDONED

DATE

JUN 29 1955

SCOUT

L. J. Harris

County Butler Elev. 1469 Co. Co.
 Sec. 8 Twp. 24 Rge. 5E
 Company J. H. Wagner
 Farm Name Walters No. 1

TOPS

DEPTH

LOG

DATUM

Loc. in Sec. _____

Anh.

Tp.

H.

Tr.

Dg.

BL.

L. Base

K.C.

B.K.C.

Ce. Burg

C.

M.

M.

K.

Mz.

Mq.

V.

S.

S.

A.

R.

P.E.

G.

T.D.

NE SE SW

Geol. _____

Contr. _____

Co. tools

Pool

DeGraff

COMPLETE

Date Comm. 6-21-55 AUG 10 195512 $\frac{1}{2}$ " @ 148 10" @ 1202 5 $\frac{1}{2}$ " @ 2440/40TD 2584 PB 2448 vis-frac 25 bopdSP 2180 15/ 2160-75 reperf.sd-oil-frac P/ 30 bopd sq perf. 2160-75CO to 2450 sd-oil-frac Comp. 30 bopd