


Section 18 Township 24 Range 5E

Well No. #1 Joseph

Company Rex & Morris

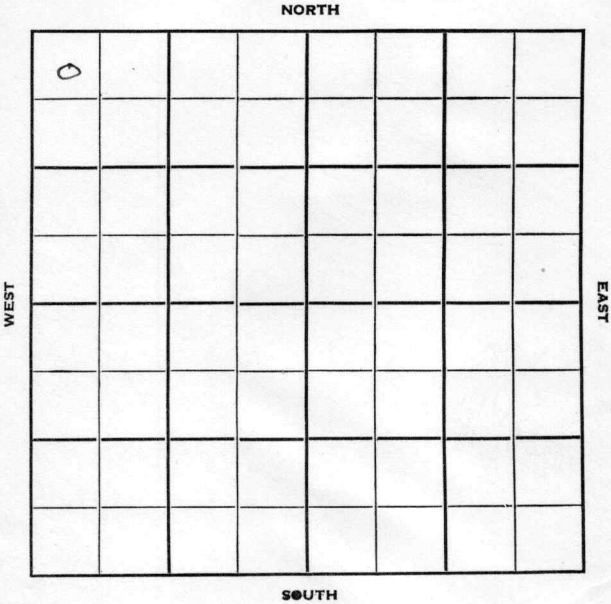

Butler

KANSAS

Sec. 18 Twp. 24 R. 5E

Well No. #1 Joseph Farm

Rex & Morris Company

Contractor

Semi Wildcat


330 Ft. from N. Line

Ft. from S. Line

Ft. from E. Line

330 Ft. from W. Line

NW NW NW

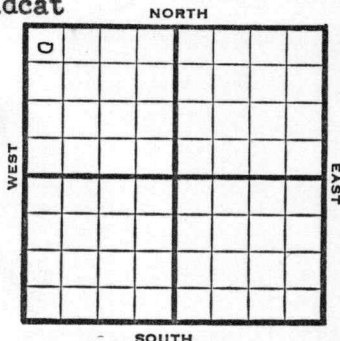

1952 Elev. 1442' REPORT

2/6 Location

2/13 8" @ 102'

2/19 D&A TD 2502

8" @ 102'

Lans. 1820 KC 2095

Cong. 2464 Miss 2481

TD 2502 D&A

ABANDONED

County **Butler** State **Kansas**
 Sec. **18** (Blk. Twp.) **24** (Sur. Rge.) **5E** Map No.

Operator **Rex & Morris**
 Well No. **1** Farm **Joseph**

Elev. Location **NW NW NW**

0							

FIRST REPORT

330 Ft. From **N** Line **NW**

330 Ft. From **W** Line Quarter

1st. Report **FEB 6 1952**

Completion

Remarks

Spudding Date

Drlg. Data **Semi Wildcat**

Location

J. G. McGEHEE

County Butler State Kansas
 Sec. 18 (Blk. 24 (Sur. 5E Map No.
 (Twp.) (Rge.)
 Operator Rex & Morris
 Well No. 1 Farm Joseph
 Elev. 1442 Location NW NW NW

0						

ABANDONED

330 Ft. From N Line NW
330 Ft. From W Line Quarter
 1st. Report
 Completion FEB 20 1952
 Remarks Semi Wildcat

Spudding Date
 Drlg. Data D & A TD 2502

8" @ 102 Lans. 1820 KC 2095

Cong. 2464 Miss. 2481 TD 2502

D & A

J. G. McGEHEE