

Sec. 18 Twp. KANSAS 24 R. 5E ✓

Well No. #2 Joseph Farm

Cox & Burns

Company

Miscellaneous


 Ft. from N. Line

990' Ft. from S. Line

990' Ft. from E. Line

 Ft. from W. Line

NW SE NE

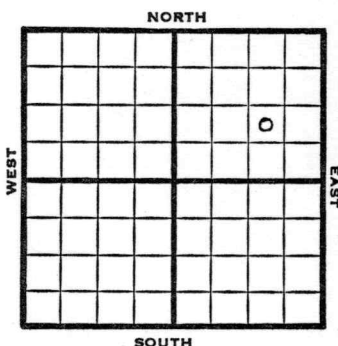

1948

Eli 1460'

REPORT

12/15

Machine

12/22

13" @ 190'

Drlg. 325'

12/29

Drlg. 790'

1/5

SD

1/12

10" @ 1183 Lansing 1830

8" @ 1889 KC 2107

Drlg 2410

1/19

TD 2553'

Chat 2484'

Aband.

ABANDONED

Map No. _____ Sec. 18 Twp. 24 R. 5EWell No. 2 Joseph
Cox & Burns Company

FIRST REPORT

Contractor

NW SE NE

SECTION PLAT

			o

_____ Ft. from N. Line

990 Ft. from S. Line990 Ft. from E. Line

_____ Ft. from W. Line

Butler County

Location _____

Rig up _____

Drilling and Remarks:

Machine

RECORD

Cased _____ in., _____ ft.

Sand _____

Gas _____

Oil _____

Total Depth _____

PRODUCTION

1st 24 hrs. Nat. _____

1st 24 hrs. after shot _____

Gas _____ Cu. Ft.

Dry Hole _____

Abandoned _____

Date

DEC 15 1948 19S. J. LEWIS Scout

Map No. 14 Sec. 18 Twp. 24 R. 5E

Well No. 2 Joseph

Cox & Burns Company

ABANDONED

Contractor

NW SE NE

E1/460
SECTION PLAT

 Ft. from N. Line

990 Ft. from S. Line

990 Ft. from E. Line

 Ft. from W. Line

			0

Butler County

Location

Rig up

Drilling and Remarks:

Cha 42484

RECORD

Cased in., ft.

Sand

Gas

Oil

Total Depth 2553

PRODUCTION

1st 24 hrs. Nat.

1st 24 hrs. after shot

Gas Cu. Ft.

Dry Hole

Abandoned

Date

JAN 19 1949

19

S. J. LEWIS

Scout