

6

1 Piatt

Marconnette

SOUTH

0

EAST

Rig Up_____

Drilling Remarks:

PRODUCTION

1st 24 hrs. Nat. _____

1st 24 hrs. after shot_____

Gas_____cu. ft.

Dry Hole _____

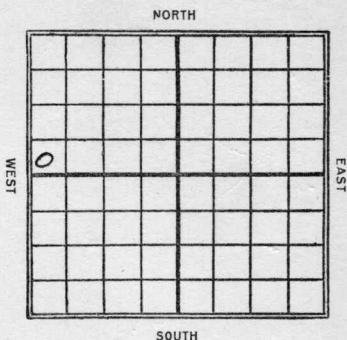
Abandoned _____

Map No. _____ Sec. 6 Twp. 24 R. 6Well No. 1 Piatt Farm _____
Marconnette Company _____

_____ Ft. from N. Line

220 Ft. from S. Line

_____ Ft. from E. Line

200 Ft. from W. Line

Date

REPORT

192210/26 Rig & tools.19231/6 Sand 2470-82-20 1806.

Map No. ¹⁴~~KANSAS~~ Sec. ⁶ Twp. ²⁴ R. ⁶Well No. ¹⁰~~Marconette~~

Company

Contractor

FIRST REPORT

SECTION PLAT

0			

Ft. from N. Line

²²⁰ Ft. from S. Line

Ft. from E. Line

²⁰⁰ Ft. from W. Line

RECORD

Location

Cased _____ in., _____ ft.

Rig up

Sand _____

Drilling and Remarks:

Gas _____

Oil _____

Total Depth _____

PRODUCTION

1st 24 hrs. Nat. _____

1st 24 hrs. after shot _____

Gas _____ Cu. Ft.

Dry Hole _____

Abandoned _____

Date

OCT 26 1922

M. A. BENEAR

Scout

Map No. **KANSAS 14** Sec. **6** Twp. **34** R. **6**

Well No. **1 Pratt**

Marcummett Company

Contractor

COMPLETED

SECTION PLAT

----- Ft. from N. Line

200 ----- Ft. from S. Line

----- Ft. from E. Line

200 ----- Ft. from W. Line

0			

Location -----

Rig up -----

Drilling and Remarks:

RECORD

Cased ----- in., ----- ft.

Sand -----

Gas -----

Oil **2470-82**

Total Depth **2482**

PRODUCTION

1st 24 hrs. Nat. **20 1/2**

1st 24 hrs. after shot -----

Gas ----- Cu. Ft.

Dry Hole -----

Abandoned -----

Date

JAN 6 1923

M. A. BENEAR

Scout