

Butler


KANSAS

SECTION 23 TOWNSHIP 24 RANGE 5 E

WELL NO. #1 Roth

COMPANY J.E.Morris et al

NORTH

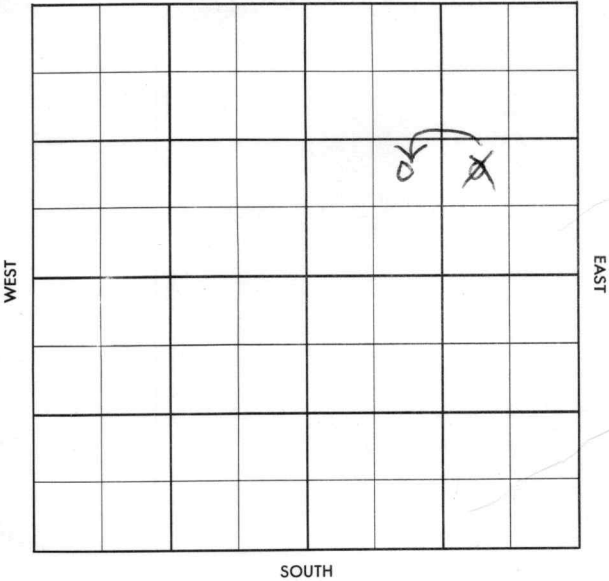

Butler

KANSAS

SEC. 23	TWP. 24	R. 5E 4E
------------	------------	-------------

WELL NO.

#1 Roth

FARM

COMPANY

J.E. Morris etal

CONTRACTOR

Rex & Morris

WILDCAT


_____ Ft. from N. Line

_____ Ft. from S. Line

_____ Ft. from E. Line

_____ Ft. from W. Line

NW SE NE

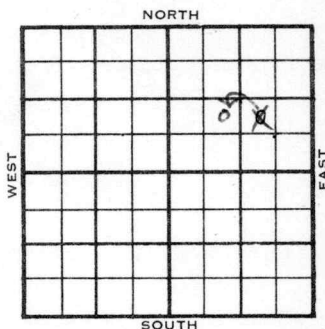

1955

ELEVATION

1425

REPORT

12-28- Location

1956

1-5

Comm. 12-27-55

8 5/8" @ 127/125

DST 2494-2502 op 1 hr. rec. 10' mud,
710#

D & A

KC 2110

Chert 2494

M. lm. 2570

Sh. 2611

V. 2710

TD 2725'

ABANDONED

Butler

Elev.

Sec.

23

Twp.

24

Rec.

5E

Company

J. E. Morris et al.

Farm Name _____

Roth

No.

1

TOPS	DEPTH	LOG	DATUM
Anh.			
Tp.			
H.			
Tr.			
Dg.			
Bl.			
L.			
K.C.			
B.K.C.			
Ce.			
C.			
M.			
M.			
K.			
Mz.			
Mq.			
V.			
S.			
S.			
A.			
R.			
Pc.			
G.			
I.D.			

Loc. in Sec. _____
NW SE NE

Geol. _____

Contr. _____
Rex & Morris

Pool _____
Wildcat

DEC 28 1955

FIRST REPORT

Date Comm.

Location

Co.

Use

No.

sec

1.

ス

FORM 513 REV. SUNRAY

TOPS	DEPTH	LOG	DATUM	Loc. in Sec.
Anh.				NE SW NE
TP.				
H.				
Tr.				
Dg.				
BL.				
L.				Geol.
K.C.				
B.K.C.				Contr.
Ce.				
C.				
M.				
M.				Pool
K.				
Mz.				
Mq.				
V.				
S.				
S.				
A				
R.				
PE.				
G.				
TP.				

Lse

No.

CORRECTION

Date Comm. JAN 5 1956

Reported NW SE NE

CORRECTION No.

County Butler Elev. 1425
 Sec. 23 Twp. 24 Rge. 4E
 Company J. E. Morris et al.
 Farm Name Roth No. 1

TOPS	DEPTH	LOG	DATUM	Loc. in Sec.
Anh.				NE SW NE
Tr.				
H.				
Dg.				
Bl.				
L.				
K.C.	<u>2110</u>		<u>685</u>	Geol.
B.K.C.				Contr.
Ce.				Rex & Morris
C.				
M. <u>chert</u>	<u>2494</u>		<u>1069</u>	Pool
M. <u>ls</u>	<u>2577</u>		<u>1145</u>	
K. <u>sh.</u>	<u>2611</u>		<u>1186</u>	Wildcat
Mz.				
Mq.				
V.	<u>2710</u>		<u>1285</u>	
S.				
S.				
A.				
R.				
Pe.				
G.				
T.D.	<u>2725</u>			

Date Comm. 12-27-55 JAN 5 1956

8 5/8" @ 127/125 DST 2494-2502

open 1 hr. rec. 10' mud 710#

D & A