
DX 78-1

Butler KANSAS

Section 6 Township 24 Range 6E

Well No. #1 Wiebe

Company ~~Red Drlg.~~ Saco Oil Co.

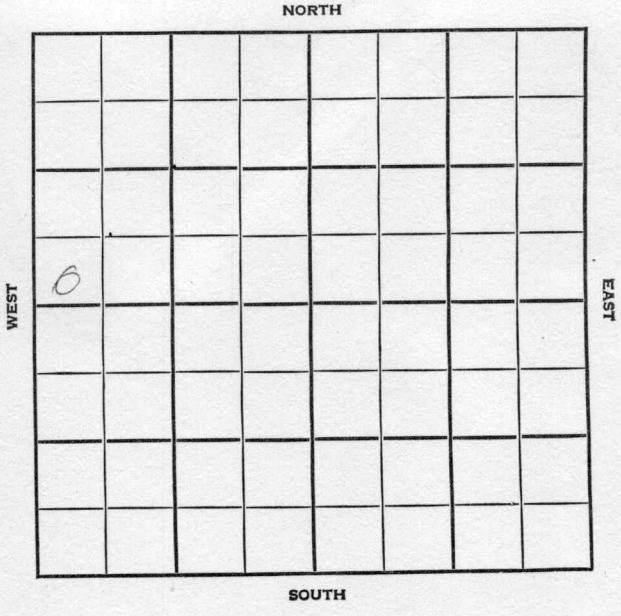

FORM 513 SUNRAY

County Butler Elev.

Sec. 6 Twp. 24 Rge. 6E

Company Red Drlg.

Farm Name Wiebe No. 1

TOPS	DEPTH	LOG	DATUM
Anh.			
Tp.			
H.			
Tr.			
Dg.			
Bl.			
L.			
K.C.			
B.K.C.			
Ce.			
C.			
M.			
M.			
K.			
Mz.			
Mo.			
V.			
S.			
S.			
A			
R.			
P€.			
G.			
T.D.			

Loc. in Sec. SW SW NW (twin)

Geol.

Contr. Co. tools

Pool

FIRST REPORT

JAN 9 '57

Date Comm. 1-7-57

R U R

Co. Lse. No. Sec. T. R.

CORRECTION

FORM 513 SUNRAY

County Butler Elev. 1414 V

Sec. 6 Twp. 24 Rge. 6E

Company ~~Red Drlg.~~ Sinco Oil Co.

Farm Name Wiebe No. 1

TOPS	DEPTH	LOG	DATUM
Anh.			
Tp.			
H.			
Tr.			
Dg.			
B.L.			
L.			
K.C.			
B.K.C.			
Ce.			
C.			
M.	2438		
M.			
K.			
Mz.			
Mo.			
V.			
S.			
S.			
A			
R.			
P€.			
G.			
T.D.	2460		

Loc. in Sec. SW SW NW (twin)

Geol.

Contr. Co. tools

Pool

JAN 30 '57

COMPLETE

Date Comm. 1-7-57

RUR 1-8-57 8 5/8?

4½ 2443 CO 2460 Ø 1½

Bo in 8 hrs 3 Barr. Acid

& cd + 550. JAN 23 '57 Hydro Frac.

P. 2 Boph + Tr. wtr. JAN 30 '57

est P. 25 Bopd + 50% wtr