


Map No. **KANSAS** Sec. 25 Twp. 24 R. 8

Well No. 1 J W Bailey Farm
Greenland & Son Company

Manhattan NORTH Kismet

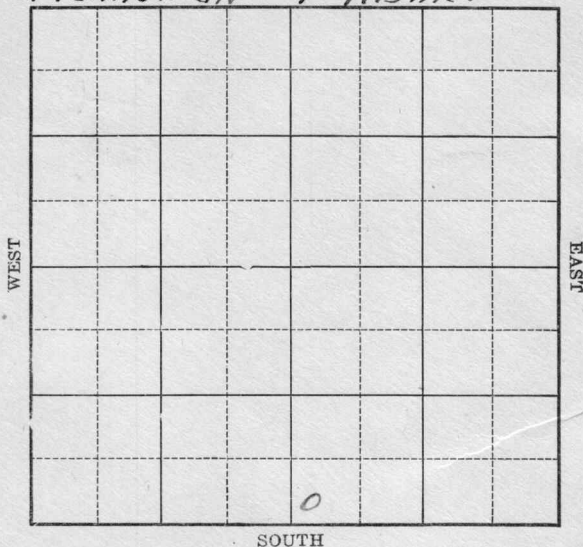

Location _____

Drilling Remarks _____

Rig Up _____

Drilling Remarks _____

RECORD

Cased _____ in. _____ ft.

Sand _____

Gas _____

Oil _____

Total Depth _____

PRODUCTION

1st 24 hrs. Nat. _____

1st 24 hrs. after shot _____

Gas _____ cu. ft.

Dry Hole _____

Abandoned _____

Butler Co

Map No. Sec. 25 Twp. 24 R. 6

Well No. 1 J. W. & Darby Farm


~~Greenland & Kismet~~ Company
Manhattan & Kismet NORTH

Ft. from N. Line

250' Ft. from S. Line

Ft. from E. Line

250' Ft. from W. Line

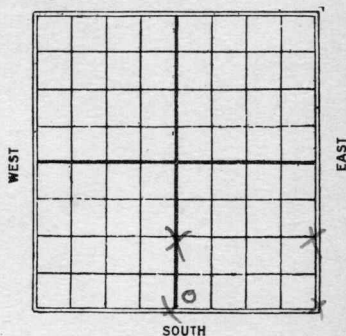

1926

Date

REPORT

1/8	Location
1/14	_____
1/20	_____
1/27	_____
2/4	_____
2/10	_____
2/17	_____
2/24	Same (chg ownership)
3/5	_____ (Acreage Contd)
3/10	_____
3/18	_____
3/25	_____
4/1	_____
4/7	Same (Acreage Co)
4/14	_____
4/21	_____
4/30	Rog.
5/21	Drq 2100' Rig
5/12	Spudding
5/19	Drq. 550'
6/2	" 1650'
6/10	" 2030

6/22- T.D. 2535 hole caving
(2el)

6/25- Drlg 25-60'

6/30- Burgess sand 2712-44 H.F.W.
T.D. 2760 Top Lume (2el)

6/30- Abandoned 2761'

14 KANSAS 25 24 6
 Map No. Sec. Twp. R.
 Well No. 1 J. W. Dabur
 Shenland & Kismet Company

Contractor

FIRST REPORTS

SECTION PLAT

Ft. from N. Line

250

Ft. from S. Line

Ft. from E. Line

250

Ft. from W. Line

Location ✓

Rig up

Drilling and Remarks:

RECORD

Cased _____ in., _____ ft.

Sand _____

Gas _____

Oil _____

Total Depth _____

PRODUCTION

1st 24 hrs. Nat. _____

1st 24 hrs. after shot _____

Gas _____ Cu. Ft.

Dry Hole _____

Abandoned _____

Date

JAN 8 1926

192

CHAS. L. SHERWOOD

Scout

Butler Co.
 114 KANSAS 25 24 6
 Map No. Sec. Twp. R.
 Well No. 1 J H Darby
 Manhattan & Gismot Company

Contractor

SECTION PLAT

Ft. from N. Line

250 Ft. from S. Line

Ft. from E. Line

250 Ft. from W. Line

CORRECTION

RECORD

Location

Cased _____ in., _____ ft.

Rig up

Sand _____

Drilling and Remarks:

Gas _____

Oil _____

Total Depth _____

PRODUCTION

1st 24 hrs. Nat. _____

1st 24 hrs. after shot _____

Gas _____ Cu. Ft.

Dry Hole _____

Abandoned _____

Date

FEB 24 1926

CHAS. L. SHERWOOD
Scout

K14 **KANSAS** Sec. *25* Twp. *24* R. *6*
 Map No. *Butler*
 Well No. *J H Bailey*
Manhattan & Sisco Company

Contractor

COMPLETED

SECTION PLAT

Ft. from N. Line

250

Ft. from S. Line

Ft. from E. Line

250

Ft. from W. Line

	ABANDONED		

Lease Contract.

Location

Rig up

Drilling and Remarks:

*sd y shob 2655-62**Burgess 2712-2744**AFM. Top line 2755**D & G 2761*

RECORD

Cased _____ in., _____ ft.

Sand _____

Gas _____

Oil _____

Total Depth *2761'*

PRODUCTION

1st 24 hrs. Nat. _____

1st 24 hrs. after shot _____

Gas _____ Cu. Ft.

Dry Hole ☒Abandoned ☒

Date

JUN 30 1926

192

CHAS. L. SHERWOOD

Scout