

Butler

NSAS


FORM 51 IOM 12-46 PETROL

Section 24 Township 24 Range 7-E

Well No. #1 Foltz

Company D on Ingling

Midcellanous NORTH

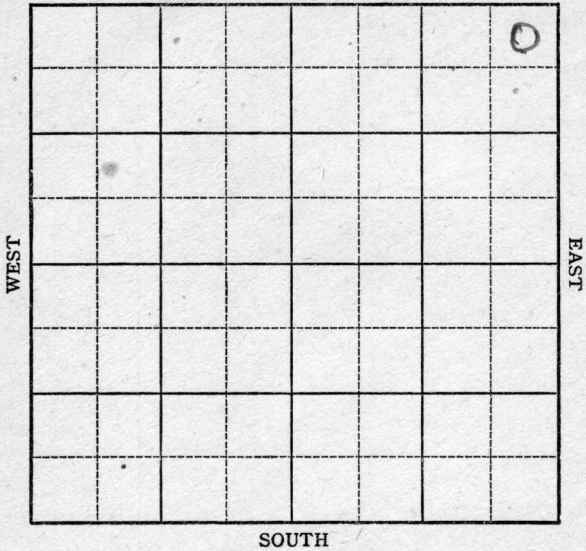

KANSAS

Butler County ✓

Sec. 24 Twp. 24 R. 7-E

Well No. 1 Foltz Farm

Don Ingling Company


Miscellaneous

330 Ft. from N. Line

 Ft. from S. Line

330 Ft. from E. Line

 Ft. from W. Line

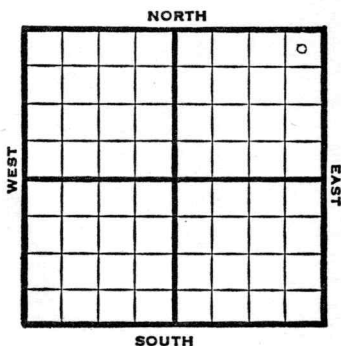

NE/C

1947 Elev. REPORT 1494'

8/20 Surface Hole

8/27 Miss. 2750'
Total Depth 2775'

ABANDONED

Map No. _____ Sec. 24 Twp. 24 R. 7E

Well No. 1 Foltz

Don Ingling Company

FIRST REPORT

Contractor

NE/C


SECTION PLAT

330 Ft. from N. Line

_____ Ft. from S. Line

330 Ft. from E. Line

_____ Ft. from W. Line

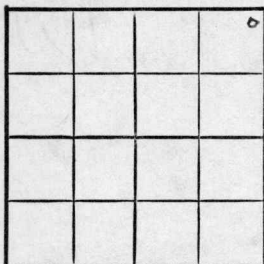

Butler County

Location _____

Rig up _____

Drilling and Remarks:

surface hole

RECORD

Cased _____ in., _____ ft.

Sand _____

Gas _____

Oil _____

Total Depth _____

PRODUCTION

1st 24 hrs. Nat. _____

1st 24 hrs. after shot _____

Gas _____ Cu. Ft.

Dry Hole _____

Abandoned _____

Date

AUG 20 1947

19

S. J. LEWIS

Scout

Map No. 15 Sec. 24 Twp. 24 R. 7E

Well No. 1 Foltz

Don Ingling Company

ABANDONED

Contractor

NE/C

E11494
SECTION PLAT

330 Ft. from N. Line

 Ft. from S. Line

330 Ft. from E. Line

 Ft. from W. Line

			o

Butler County

Location

Rig up

Drilling and Remarks:

Miss 2700

RECORD

Cased in., ft.

Sand

Gas

Oil

Total Depth 2725

PRODUCTION

1st 24 hrs. Nat.

1st 24 hrs. after shot

Gas Cu. Ft.

Dry Hole

Abandoned

Date

AUG 27 1947

19

S. J. LEWIS

Scout