


STATE <i>Kansas</i>		COMPANY <i>BPR Drilg. Co.</i>
COUNTY <i>Phillips</i>	FARM <i>Jackson</i>	WELL NO. <i>#4</i>
BLOCK	SURVEY	
SEC. <i>5</i>		
T. <i>2S</i>	R. <i>18W</i>	TOTAL DEPTH <i>3451</i>
COMMENCED <i>Nov. 28, 1949</i>		
COMPLETED <i>Dec. 7, 1949</i>		
REMARKS		
ALTITUDE <i>2202</i>		
PRODUCTION		

CASING RECORD

SHOT	QUARTS	BETWEEN
------	--------	---------

FORM 186 - In stock and for sale by Mid-West Prtg. Co., Tulsa

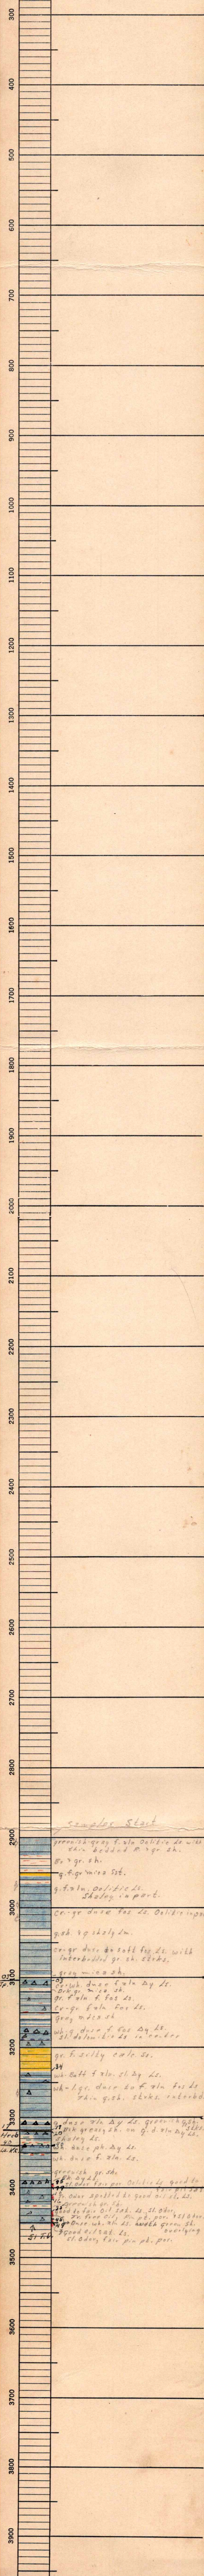

Phillips
 Jackson
 Farm
 Co. B. Stableford + B + R Drilling Company
 County No. 4
 Range 18
 Township 2
 Section 5
 Sec.

 Twp.

6	5	4	3	X	1
7	8	9	10	11	12
13	14	15	16	17	18
19	20	21	22	23	24
25	26	27	28	29	30
31	32	33	34	35	36

 Elev 2199 T.D. 3490
 Date Drilled 12-7-49
 Correlation by
 Prod: Phy. Pot. 81 bbls.

