


Map No. 8 Sec. 1 Twp. 24 R. 9
 Well No. 6 Cartwright Farm
Roth & Mission Company

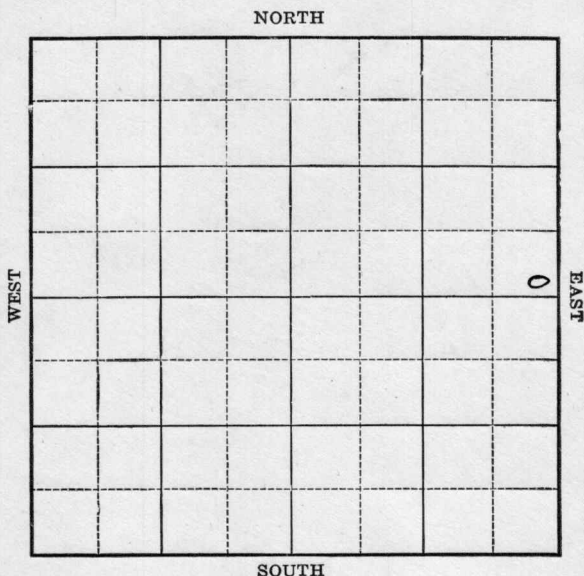

Location _____

Drilling Remarks:

Rig Up _____

Drilling Remarks:

RECORD

Cased _____ in. _____ ft.

Sand _____

Gas _____

Oil _____

Total Depth _____

PRODUCTION

1st 24 hrs. Nat. _____

1st 24 hrs. after shot _____

Gas _____ cu. ft.

Dry Hole _____


Abandoned _____

Map No. K Sec. 1 Twp. 24 R. 9Well No. 1 - Cartwright Farm
Booth Ed Mission Company

Ft. from N. Line

200 Ft. from S. Line200 Ft. from E. Line

Ft. from W. Line

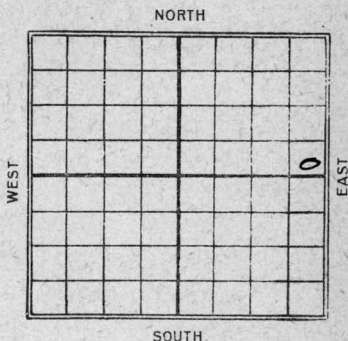Date 1924

REPORT

6/10

6" Top sand 2255
F. Oil 2315
Bottom sand 2358
Td. 2361'
1007 25 Bbls

15 KANSAS

Map No. _____ Sec. _____ Twp. 24 R. 9

Well No. 1 Cartering Co.
Rath Mission Co. Company

Contractor _____

FIRST REPORT

and COMPLETED

Ft. from N. Line

200 Ft. from S. Line

200 Ft. from E. Line

Ft. from W. Line

SECTION PLAT

			0

Location _____

Rig up _____

Drilling and Remarks:

LO 790'
6" Tap 2255'
70. 2305'
Bore 2355'
70. 2361'

RECORD

Cased _____ in., _____ ft.

Sand _____

Gas _____

Oil _____

Total Depth _____

PRODUCTION

1st 24 hrs. Nat. _____

1st 24 hrs. after shot _____

Gas _____ Cu. Ft.

Dry Hole _____

Abandoned _____

Date

100/25
JUN 10 1924

M. A. BENEAR

192

Scout