


Map No. 15 Sec. 1 Twp. 34 R. 9Well No. 2 - Carter right FarmRoth & Harriott. Company

NORTH

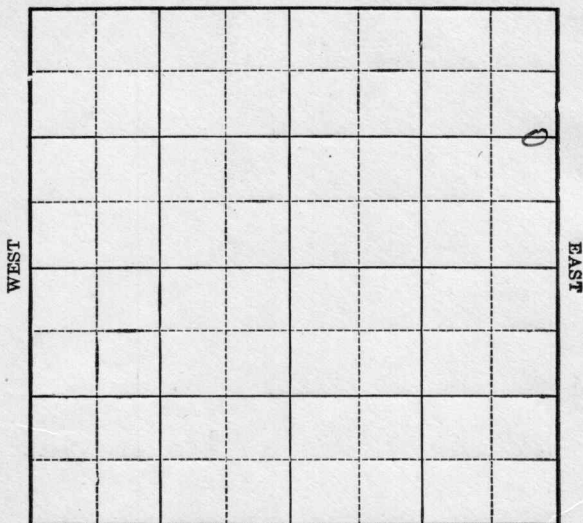

SOUTH

Location _____

Drilling Remarks:

Rig Up _____

Drilling Remarks:

RECORD

Cased _____ in. _____ ft.

Sand _____

Gas _____

Oil _____

Total Depth _____

PRODUCTION

1st 24 hrs. Nat. _____

1st 24 hrs. after shot _____

Gas _____ cu. ft.

Dry Hole _____

Abandoned _____


Map No. 11 Sec. 1 Twp. 24 R. 9
 Well No. 2. Carterwright Farm
Roth & Harroun. Company

1320 Ft. from N. Line

1 Ft. from S. Line

200 Ft. from E. Line

_____ Ft. from W. Line

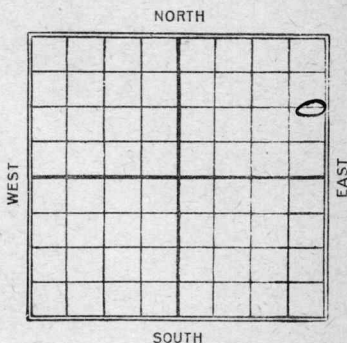

Date

REPORT

1904

7/2 Roy

7/16

9/9 Sep 2265

Feb 2295

May - 2305 - 30

72. 2350

100 / 3513 bbls

15 KANSAS Map No. _____ Sec. 1 Twp. 24 R. 9

Well No. #2 Cortwright
Rath & Farrant Company

Contractor

FIRST REPORT

SECTION PLAT

1320 Ft. from N. Line

_____ Ft. from S. Line

200 Ft. from E. Line

_____ Ft. from W. Line

			0

Location _____

Rig up _____

Drilling and Remarks:

ROB

RECORD

Cased _____ in., _____ ft.

Sand _____

Gas _____

Oil _____

Total Depth _____

PRODUCTION

1st 24 hrs. Nat. _____

1st 24 hrs. after shot _____

Gas _____ Cu. Ft.

Dry Hole _____

Abandoned _____

Date

JUL 9 1924

192

Scout

15
 Map No. KANSAS Sec. 1 Twp. 24 R. 9

Well No. 2 Cartwright
Kath & Farhart Company

Contractor

COMPLETED SECTION PLAT

1320 Ft. from N. Line

_____ Ft. from S. Line

200 Ft. from E. Line

_____ Ft. from W. Line

			0

Location _____

Rig up _____

Drilling and Remarks:

Tap. 2265'
7.0. 2295'
Pay 2305' - 30
ID. 2350'
100/35'

RECORD

Cased _____ in., _____ ft.

Sand _____

Gas _____

Oil _____

Total Depth _____

PRODUCTION

1st 24 hrs. Nat. _____

1st 24 hrs. after shot _____

Gas _____ Cu. Ft.

Dry Hole _____

Abandoned _____

Date

SEP 9 1924

192

M. A. BENEAR

Scout