


Map No. Kan Sec. 1 Twp. 24 R. 9
Well No. 9 Cartwright Farm
Roth & Mission Company

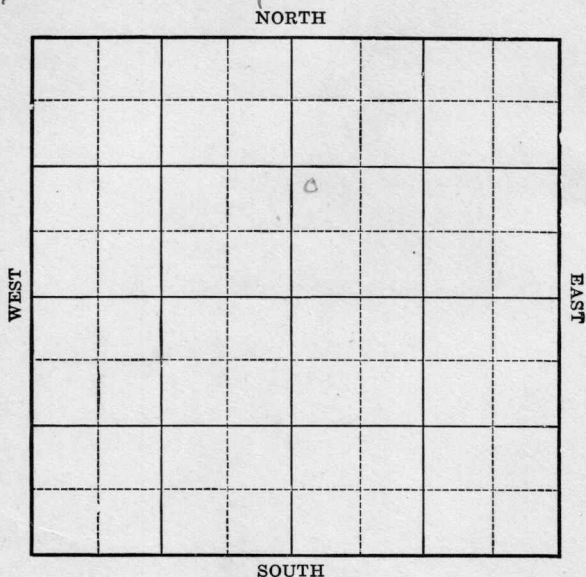

Location _____
Drilling Remarks _____

RECORD

Cased _____ in. _____ ft.
Sand _____
Gas _____
Oil _____
Total Depth _____


Rig Up _____
Drilling Remarks _____

PRODUCTION

1st 24 hrs. Nat. _____
1st. 24 hrs. after shot _____
Gas _____ cu. ft.
Dry Hole _____
Abandoned _____

Map No. *Kan* Sec. *1* Twp. *24* R. *9*
 Well No. *9 Cartwright* Farm
Roth & Mission Company

NORTH

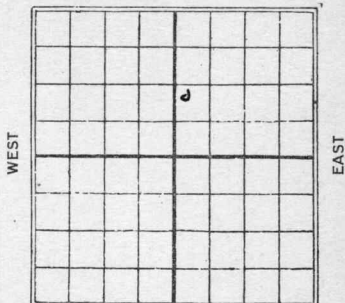

Ft. from N. Line

990 Ft. from S. Line

Ft. from E. Line

330 Ft. from W. Line

SOUTH

Date

REPORT

1925
7/13 Bldg rig
7/10 Rig
7/17 Spud
7/24 1000
7/31 1480
8/17 Dry sand 2300-2304'
Tap sand 2347' & Orlg. 2350'
8/14 sand 2347-2390
30/15 bbb

Map No. 15 Sec. 1 Twp. 24 R. 9Well No. 9Both & Mission & Co Company

Contractor

FIRST REPORTS

Ft. from N. Line

990 Ft. from S. Line

Ft. from E. Line

330 Ft. from W. Line

SECTION PLAT

		o	

Location

Rig up Blog

Drilling and Remarks:

RECORD

Cased _____ in., _____ ft.

Sand _____

Gas _____

Oil _____

Total Depth _____

PRODUCTION

1st 24 hrs. Nat. _____

1st 24 hrs. after shot _____

Gas _____ Cu. Ft.

Dry Hole _____

Abandoned _____

Date

JUL 3 1925

CHAS. L. SHERWOOD

192

Scout

Form 26-1M Bks.-3-23-11959. *Merwood 2*
Map No. *15* KANSAS Sec. *1* Twp. *24* R. *9*
Well No. *9 Cartwright*
Both 2 Missions a/c. Company
Contractor

COMPLETED

SECTION PLAT

_____ Ft. from N. Line
990 Ft. from S. Line
_____ Ft. from E. Line
330 Ft. from W. Line

		0	

Location _____
Rig up _____
Drilling and Remarks:

30/15 bks.

RECORD

Cased _____ in., _____ ft.
Sand *2347-2390'*
Gas _____
Oil _____
Total Depth *2390'*

PRODUCTION

1st 24 hrs. Nat. _____
1st 24 hrs. after shot _____
Gas _____ Cu. Ft.
Dry Hole _____
Abandoned _____

Date
AUG 14 1925 CHAS. L. SHERWOOD
_____ 192__ Scout