

Map No. _____ Sec. 7 Twp. 27 R. 7

Well No. 10 To Arlington Farm

Company

NORTH

WEST

EAST

SOUTH

Location _____

Drilling Remarks

Rig Up

Drilling Remarks

RECORD

Cased _____ in. _____ ft.

Sand

Gas

Oil

Total Depth.....

PRODUCTION

1st 24 hrs. Nat. _____

1st. 24 hrs. after shot.....


Gas _____ cu. ft.

Dry Hole

Abandoned -----

Map No. *Kans* Sec. *1* Twp. *24* R. *9*
 Well No. *10 Cartwright* Farm
Rath-Mission et al. Company

NORTH

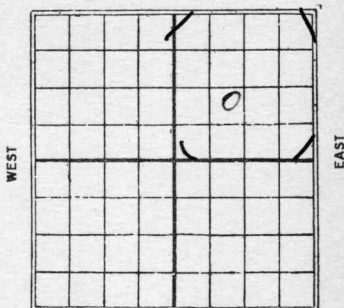

Ft. from N. Line

1256 Ft. from S. Line

Ft. from E. Line

1256' Ft. from W. Line

SOUTH

1925

Date	REPORT
<i>8/14</i>	<i>Timbers</i>
<i>8/20</i>	<i>_____</i>
<i>8/27</i>	<i>_____</i>
<i>9/3</i>	<i>_____</i>
<i>9/11</i>	<i>_____</i>
<i>9/16</i>	<i>_____</i>
<i>9/24</i>	<i>_____</i>
<i>10/1</i>	<i>_____</i>
<i>10/8</i>	<i>_____</i>
<i>10/16</i>	<i>same</i>
<i>10/22</i>	<i>_____</i>
<i>10/29</i>	<i>_____</i>
<i>11/6</i>	<i>_____</i>
<i>11/13</i>	<i>_____</i>
<i>11/19</i>	<i>_____</i>
<i>11-27</i>	<i>_____</i>
<i>12/3</i>	<i>_____</i>
<i>12/10</i>	<i>_____</i>
<i>12/17</i>	<i>_____</i>
<i>12/23</i>	<i>_____</i>
<i>12/31</i>	<i>_____</i>
<i>1926</i>	<i>_____</i>
<i>1/8</i>	<i>_____</i>

1/14 - same

1/20 - _____

1/24 - _____

2/4 - _____

2/10 - _____

2/17 - _____

2/24 - _____

3/5 - _____

3/10 - Building Rig

3/18 - Rig

3/25 - _____

4/1 - _____

4/7 - Drilling 1025

4/14 - " 1750

4/21 - _____

4/29 - Ld. - 2307 - 2357 - J.D.

100/20 Bbls.

Map No. 15 **KANSAS** Sec. 1 Twp. 24 R. 9Well No. 10 *Cartwright*
Roth-Mission *et al* Company

Contractor

FIRST REPORTS

Ft. from N. Line

1256

Ft. from S. Line

Ft. from E. Line

1256

Ft. from W. Line

SECTION PLAT

Location

Rig up *Timbers*

Drilling and Remarks:

RECORD

Cased _____ in., _____ ft.

Sand _____

Gas _____

Oil _____

Total Depth _____

PRODUCTION

1st 24 hrs. Nat. _____

1st 24 hrs. after shot _____

Gas _____ Cu. Ft.

Dry Hole _____

Abandoned _____

Date

AUG 14 1925

CHAS. L. SHERWOOD

192

Scout

Greenwood
 K15 KANSAS Sec. *1* Twp. *24* R. *9*
 Map No. _____
 Well No. *10 Contwary #1*
Booth-Mission Oil & Gas Company

Contractor _____

COMPLETED

SECTION PLAT

		0	

_____ Ft. from N. Line

1256 _____ Ft. from S. Line

_____ Ft. from E. Line

1256 _____ Ft. from W. Line

Location _____

Rig up _____

Drilling and Remarks:

100/20 BS

RECORD

Cased _____ in., _____ ft.

Sand *2307-2357'*

Gas _____

Oil _____

Total Depth *2357'*

PRODUCTION

1st 24 hrs. Nat. _____

1st 24 hrs. after shot _____

Gas _____ Cu. Ft.

Dry Hole _____

Abandoned _____

Date

APR 28 1926

192

CHAS. L. SHERWOOD

Scout